IREDELL COUNTY HEALTH DEPARTMENT

STATESVILLE 704-878-5305 MOORESVILLE 704-664-5281

IMPROVEMENT PERMIT / CERTIFICATE OF COMPLETION / OPERATION PERMIT / EXISTING SYSTEM INSPECTION

PROPERTY DESCRIPTION NO. REPAIR DATE 1-3-96 TAX MAP NO

OWNER OR CONTRACTOR MICHAEL DEAN HEDRICK PHONE: Business 873-7237 Home Watershed: [ ] Yes [X] No

ADDRESS 108 GREEN BAY DR MOORESVILLE, NC 28115

LOCATION US 21 N, TL NC901 W, TL POWERS FARM RD, LAST DWELLING ON LEFT

SUBDIVISION BLOCK / SECTION LOT LOT AREA AMPLE SITE CLASS. PS DESIGN FLOW 360 L.T.A.R. EXISTING

Septic Tank: EXISTING Gallons: STB Date

Pump Tank: Gallons: PT Date

Pump Make: Model Serial No.

Nitrification Field: No Fields 1 Square Feet 900 Linear Feet 300

No Lines 3 Trench Width 36" Max Trench Bottom Depth 18-36" Gravel Depth 12"

[ ] New System [X] Repair System Type: I II III IV V VI

System Description: CONV. GRAVITY

Repair System Description: CONV. GRAVITY

Maintenance Agreement Required: [ ] Yes [ ] No

[ ] Slab [X] Crawl Space [ ] Basement w/plumbing [ ] Basement wo/plumbing

[ ] House/Mod. Home No. Bedrooms 3

[X] Mobile Home No. Bathrooms 1

[ ] Business No. Employees


[ ] Other

Water Supply: [ ] Individual [ ] Community [X] Public


Comments: ① REMOVE EXISTING FIELD TERRACE ② CHECK SEPTIC TANK FOR INTEGRITY, REPLACE SANITARY TEE IF NECESSARY ③ INSTALL THREE NEW DISTRIBUTION BOXES FEEDING THREE 100' LINES AS SHOWN

Comments:

INITIAL SITE SKETCH

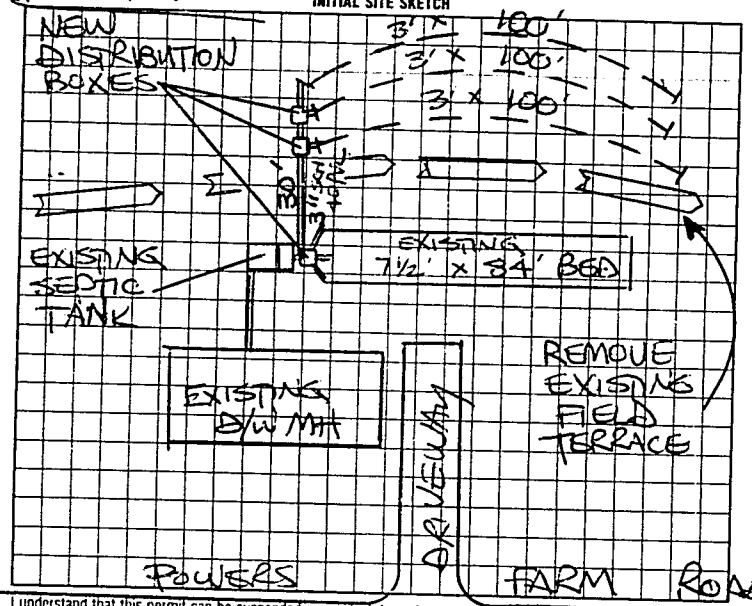

AS BUILT SKETCH

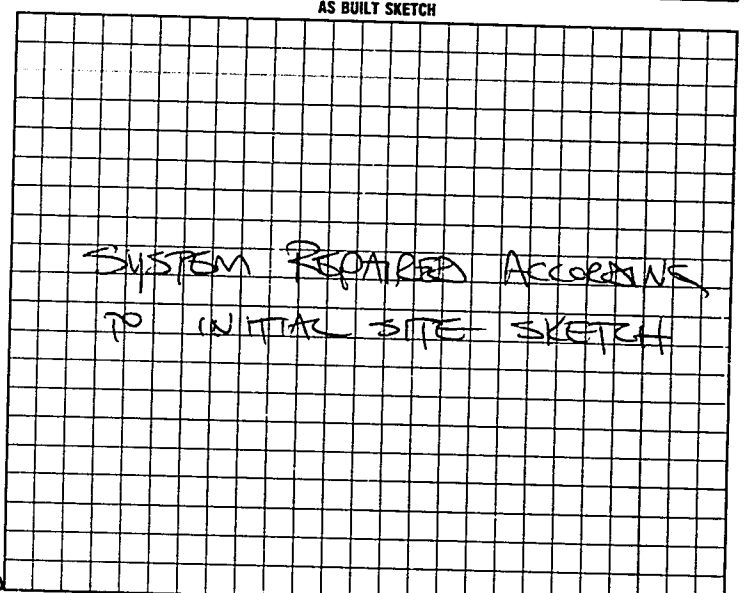

I understand that this permit can be suspended or revoked if any false information is supplied toward securing the permit/any unauthorized changes are made to the site/any unauthorized changes are made in the installation of the system.

AUTHORIZATION TO CONSTRUCT IS VALID FIVE (5) YEARS FROM DATE OF ISSUANCE. IMPROVEMENT PERMIT HAS NO EXPIRATION DATE

Signed: X [signature]

Improvement Permit by: STEVE HEDRICK date 1/3/96

AUTHORIZATION TO CONSTRUCT

Existing System Inspection by: STEVE HEDRICK date 1/3/96

Installed by: TOMMY FRYE

~~Certificate of Completion by:~~ date

Operation Permit by: STEVE HEDRICK date 3-22-96

HEALTH DEPT COPY: WHITE | INSPECTION COPY (FINAL) GREEN | OWNER COPY (FINAL) YELLOW | INSPECTION COPY (INITIAL) PINK | OWNER COPY (INITIAL) GOLD