IREDELL COUNTY HEALTH DEPARTMENT

STATESVILLE 704-878-5305 MOORESVILLE 704-664-5281

IMPROVEMENT PERMIT / CERTIFICATE OF COMPLETION / OPERATION PERMIT / EXISTING SYSTEM INSPECTION

PROPERTY DESCRIPTION NO. 25957 DATE 2-17-97 TAX MAP NO. 4871123389 Watershed: ☐ Yes ☒ No

OWNER OR CONTRACTOR JAMES QUEEN PHONE: Business Home 539-4992

ADDRESS 430 HOWARD BRIDGE RD, UNION GROVE, NC 28689

LOCATION US 21 N, TL NC 901, ~1.3 MILES ON LEFT

SUBDIVISION _____ BLOCK / SECTION _____ LOT _____ LOT AREA 31.09 ACRES SITE CLASS. PS DESIGN FLOW 240 L.T.A.R. 0.36GPD/FT²

Septic Tank: 1000 Gallons; STB 1012 Date 10-26-96

Pump Tank: _____ Gallons; PT _____ Date _____

Pump Make: _____ Model _____ Serial No. _____

Nitrification Field: No Fields 1 Square Feet 810 Linear Feet 270

No Lines THREE Trench Width 36" Max Trench Bottom Depth 36" Gravel Depth 12"

☒ New System ☐ Repair System Type: I, II, III, IV, V, VI

System Description: CONVENTIONAL GRAVITY

Repair System Description: CONV. GRAVITY

Maintenance Agreement Required: ☐ Yes ☒ No

☐ House/Mod. Home ☒ Mobile Home ☐ Business ☐ Other

No. Bedrooms 2 No. Bathrooms 1 No. Employees ____


☐ Slab ☒ Crawl Space ☐ Basement w/plumbing ☐ Basement wo/plumbing

Water Supply: ☐ Individual ☐ Community ☒ Public

Comments:

Comments:

INITIAL SITE SKETCH

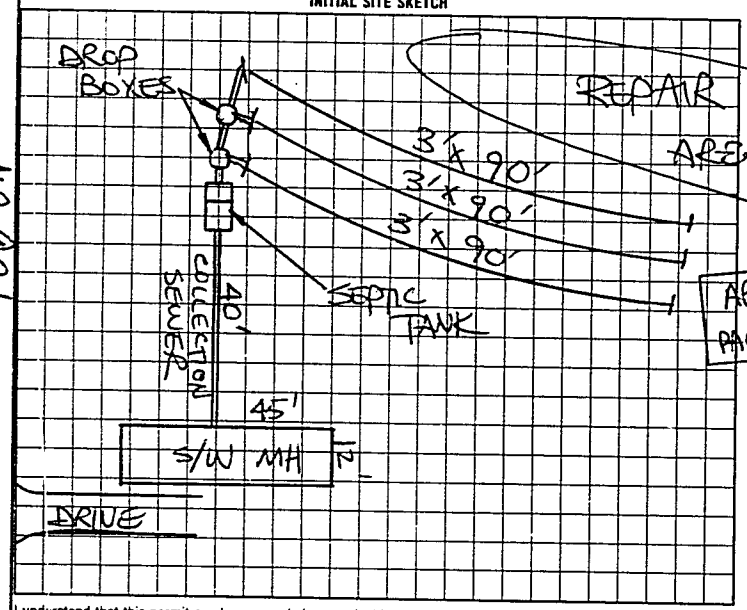

AS BUILT SKETCH

SYSTEM INSTALLED ACCORDING TO INITAL SITE SKETCH

I understand that this permit can be suspended or revoked if any false information is supplied toward securing the permit/any unauthorized changes are made to the site/any unauthorized changes are made in the installation of the system. Improvement Permit is valid for 60 months from date of issuance. AUTH. TO CONST. IS VALID 60 MONTHS FROM DATE OF ISSUANCE.

Signed: [signature]

Improvement Permit by: STEVE HEDRICK date 2-17-97

AUTH. TO CONST.

~~Existing System Inspection~~ by: STEVE HEDRICK date 2-17-97

Installed by: KENNY MADISON

~~Certificate of Completion by:~~ _____ date _____

Operation Permit by: STEVE HEDRICK date 2-19-97

HEALTH DEPT. COPY: WHITE INSPECTION COPY (FINAL): GREEN OWNER COPY (FINAL): YELLOW INSPECTION COPY (INITIAL): PINK OWNER COPY (INITIAL): GOLD