46054

IREDELL COUNTY HEALTH DEPARTMENT

STATESVILLE 704-878-5305 MOORESVILLE 704-664-5281

IMPROVEMENT PERMIT / CERTIFICATE OF COMPLETION / OPERATION PERMIT / EXISTING SYSTEM INSPECTION

PROPERTY DESCRIPTION NO. 15667 DATE 6/9/93 TAX MAP NO. 17F- A- 88

OWNER OR CONTRACTOR WOODROW CLARK PHONE: Business Home

ADDRESS

LOCATION I-77N, TR NC 901E, TL KIMMON RD, TR AT STOP SIGN, 1ST (L) ON (R) AFTER CURVE TO (L)

SUBDIVISION BLOCK / SECTION LOT LOT AREA 110' X 200' SITE CLASS. PS L.T.A.R. 0.36 GPD/SF

Water Supply: ☑ Individual ☐ Community ☐ Public WELL

Septic Tank: 1000 Gallons; STB 358 Date 3/19/93

Pump Tank: Gallons; PT Date

Nitrification Field: No Fields 1 Square Feet 975 Linear Feet 325

No Lines 5 Trench Width 3' Trench Depth 28" Gravel Depth 12"

☑ New System ☐ Repair System Type: I. II (III) IV. V. VI

System Description: CONV, GRAVITY

Repair System Description: CONV, GRAVITY

Maintenance Agreement Required: ☐ Yes ☑ No

☑ House/Mod. Home No. Bedrooms 3 Garbage Disposal: ☐ Yes ☑ No

☐ Mobile Home No. Bathrooms 1.5 Auto. Dishwasher: ☐ Yes ☐ No

☐ Business No. Employees Auto. Washing Machine: ☑ Yes ☐ No


☐ Other Other

☐ Slab ☑ Crawl Space ☐ Basement w/plumbing ☐ Basement wo/plumbing

Comments

INITIAL SITE SKETCH

AS BUILT SKETCH

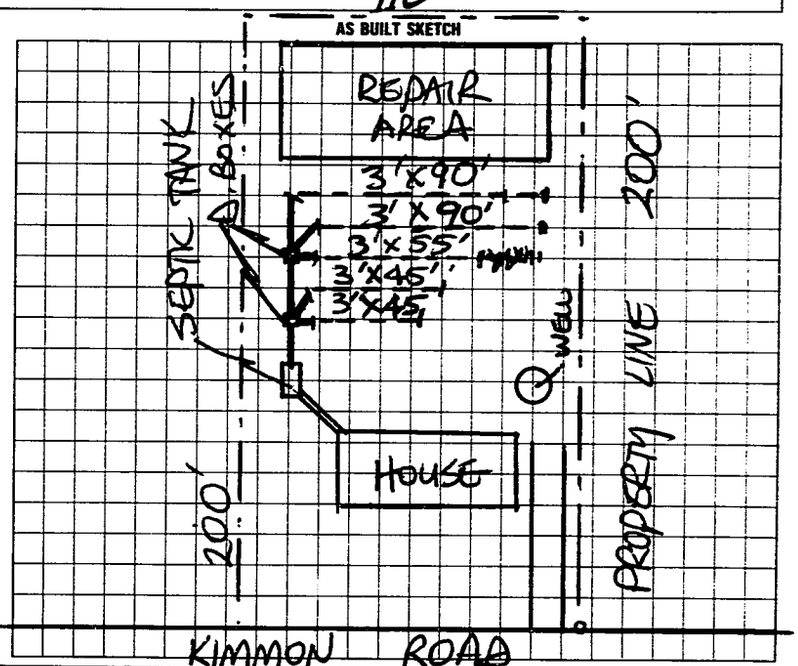

I understand that this permit can be suspended or revoked if any false information is supplied toward securing the permit/any unauthorized changes are made to the site/any unauthorized changes are made in the installation of the system. Improvement Permit is valid for 60 months from date of issuance.

Signed:

Improvement Permit by: STEVE HEDRICK date 1/15/93

Existing System Inspection by: date

Installed by: A-1 BACKHOE

Certificate of Completion by: STEVE HEDRICK date 6/9/93

Operation Permit by: date

HEALTH DEPT. COPY: WHITE INSPECTION COPY (FINAL): GREEN OWNER COPY (FINAL): YELLOW INSPECTION COPY (INITIAL): PINK OWNER COPY (INITIAL): GOLD