IREDELL COUNTY HEALTH DEPARTMENT

STATESVILLE 704-878-5305 MOORESVILLE 704-664-5281

IMPROVEMENT PERMIT / AUTHORIZATION TO CONSTRUCT / OPERATION PERMIT / EXISTING SYSTEM INSPECTION

PERMIT# 144270 PIN# 4871-18-5589 DATE 8-13-07

OWNER OR APPLICANT FREEDOM HOMES - STATESVILLE #664 PHONE: Business 704-872-0179 Home

ADDRESS 1270 NORTHSIDE DRIVE STATESVILLE NC 28677

LOCATION US 21 NORTH, TL NC901, TR NEBO ROAD, TR KIMMON ROAD, AT END ON RIGHT

SUBDIVISION BLOCK / SECTION LOT LOT AREA .07 ACRES SITE CLASS PS DESIGN FLOW 360 L.T.A.R. ~~EXISTING~~

Septic Tank: 1000 Gallons; STB Date

Pump Tank: Gallons; PT Date

Pump Make: Model Serial No.

Nitrification Field: No Fields 1 Square Feet Linear Feet 125'

No Lines 1 BED Trench Width 5' Max Trench Bottom Depth Gravel Depth

☐ New System ☐ Repair ☐ Expansion System Type: I II III IV V VI

System Description: CONVENTIONAL, GRAVITY

Repair System Description:

Maintenance Agreement Required: ☐ Yes ☒ No

☐ Gravity ☐ Pressure

☐ House/Mod. Home ☐ Mobile Home ☐ Business ☐ Other

No. Bedrooms 3 No. Persons No. Employees

☐ Slab ☒ Crawl Space ☐ Basement w/plumbing ☐ Basement wo/plumbing

Water Supply: ☒ Individual ☐ Public ☐ Community WELL

Comments:/Conditions:


INITIAL SITE SKETCH

Comments:/Conditions: P.L. 210.00'

SYSTEM IS UNDERSIZED ACCORDING TO TODAYS STANDARDS

AS BUILT SKETCH

SCALE: 1" = 50'

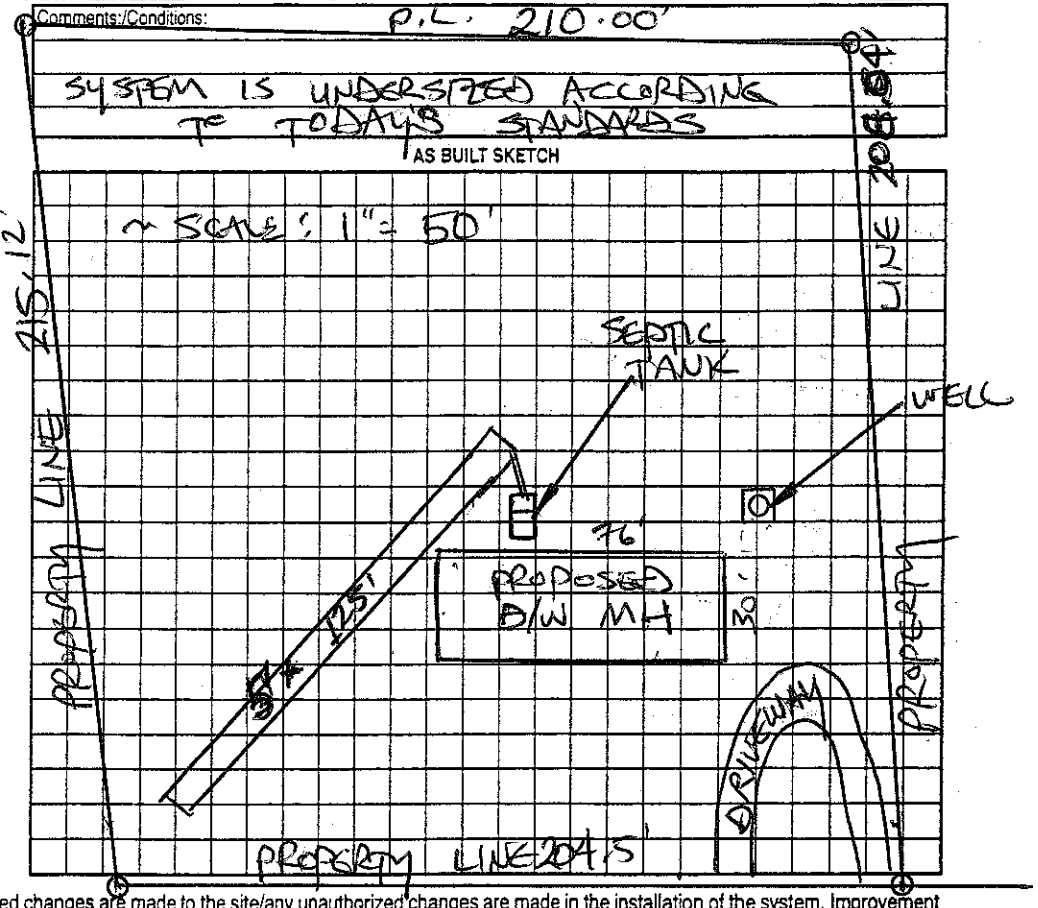

Permit can be suspended or revoked if any false information is supplied toward securing the permit/any unauthorized changes are made to the site/any unauthorized changes are made in the installation of the system. Improvement Permit with plat valid without expiration ☐ Improvement Permit with site plan valid for sixty months ☐ Authorization to Construct is valid for a period equal to that of Improvement Permit, not to exceed sixty months.

Signed: date

Improvement Permit by: date

Authorization to Construct by: date

~~Installed by:~~

Operation Permit by: date

Existing System Inspection by: STEVE HEDRICK date 8-13-07

HEALTH DEPT. COPY: WHITE OWNER COPY (FINAL): YELLOW OWNER COPY (INITIAL): PINK