IREDELL COUNTY HEALTH DEPARTMENT

STATESVILLE 704-878-5305 MOORESVILLE 704-664-5281

IMPROVEMENT PERMIT / AUTHORIZATION TO CONSTRUCT / OPERATION PERMIT / EXISTING SYSTEM INSPECTION

ad

PERMIT # 170193 PIN # 4871-18-9681 DATE JANUARY 17, 2012

OWNER or APPLICANT LARRY TURNER PHONE: Business Home: 704-402-6175

OWNER or APPLICANT ADDRESS 5381 KIMMON ROAD, HARMONY NC 28634

LOCATION / DIRECTIONS US 21 N, TL NC 901, TR NCSO RD, TR KIMMON RD TO END BEAR RIGHT

SUBDIVISION BLOCK / SECTION LOT # LOT AREA 6 ACRES DESIGN FLOW 240 L.T.A.R. EX.

Septic Tank 1000 Gallons: STB Date

Pump Tank Gallons: P T Date

Pump Make Model Serial #

Nitrification Field No Fields 1 No Lines 3 Linear Feet 270

Trench Width 36" Max. Trench Bottom Depth 30" Gravel Depth 12" ☑ GRAVITY ☐ PRESSURE

☐ New System ☐ Repair ☐ Expansion System Type I II III IV V VI

System Description: CONVENTIONAL GRAVITY

Repair System Description: CONVENTIONAL GRAVITY

Maintenance Agreement Required ☐ YES ☒ NO

☑ Residence No. Bedrooms 2 ☐ Business No. Persons ☐ Other No. Employees ☐ Slab ☑ Crawl Space ☐ Basement w/plumbing ☐ Basement w/o plumbing


Water Supply: ☐ Private ☒ Public ☐ Community

Comments / Conditions

Comments / Conditions KEEP BUILDING FOUNDATION MINIMUM FIVE FEET FROM SYSTEM

INITIAL SITE SKETCH

AS BUILT SKETCH

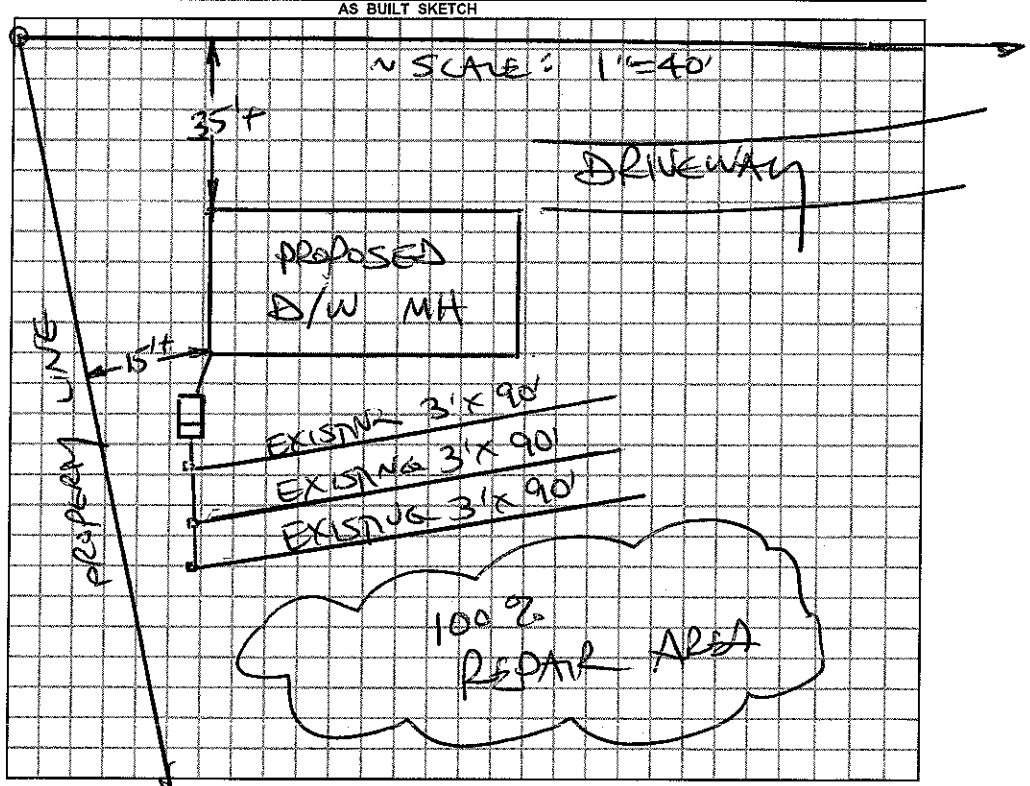

Permit can be suspended or revoked if any false information is supplied toward securing the permit / any unauthorized changes are made to the site / any unauthorized changes are made in the installation of the system.

☐ *IMPROVEMENT PERMIT w / plat valid without expiration.* ☐ *IMPROVEMENT PERMIT w / site plan valid for 60 mos.* ☐ *AUTHORIZATION TO CONSTRUCT valid for period equal to IMPROVEMENT PERMIT-not to exceed 60 mo.*

Owner / Applicant Signature: Date

Improvement Permit by: Date

Authorzation to Construct by: Date

YOU SHOULD CONTACT A LOCATOR SERVICE PRIOR TO ANY EXCAVATION.

Installed by:

Operation Permit by: Date:

Existing System Inspected by: STEVE HEDRICK Date: 1-17-2012

WHITE COPY Environmental Health YELLOW COPY (Final) Owner / Applicant PINK COPY (Initial) Owner / Applicant