(BB)

IREDELL COUNTY HEALTH DEPARTMENT

Statesville Office (704) 878-5305 Mooresville Office (704) 660-3625 PERMIT # AP-311387

SEPTIC IMPROVEMENT PERMIT / AUTHORIZATION TO CONSTRUCT / OPERATION PERMIT / EXISTING SYSTEM

PIN # 4871213289

APPLICANT/OWNER: Clayton Homes - Kelly Legacy TR APPLICANT ADDRESS: 2026 Northside Dr. Statesville, NC 28625

SITE ADDRESS: 344 W. Memorial Hwy. Harmony NC 28634 PHONE: 704-902-4659 ALT. PHONE 707-873-2547

SITE DIRECTIONS: 77N T/R 901 Site on right across from 341 W. Memorial Hwy SAP CONTROLLED: ☐ YES ■ NO


SUBDIVISION: W L Davis Farm SECTION: N/A LOT # 22 LOT AREA: 0.53 ac DESIGN FLOW: 360 L.T.A.R.: 0.25

Septic Tank	1000	(gal)	STB	1012	Date	3-20-21	■ New System ☐ Repair ☐ Expansion	System Type: I II (III) IV V VI	■ Residence	No. Bedrooms	3	Water Supply
Pump Tank		(gal)	PT	17	Date	11-20-20	System Description:	PM PPBPS	☐ Business	No. Persons	6	☐ Private
Pump Make	Gwlds		Model	LVE0512 HHV	Serial #	L205475	Repair	Repair Exempt	☐ Other	No. Employees		■ Public
# Nitrification Fields	1		# Lines	4	Linear Ft:	240'	Maintenance Agreement Required:	☐ YES ■ NO	☐ Slab	■ Crawl Space		☐ Community
Trench Width	24"		Trench Bottom Depth(Low-side)			30"	Gravel Depth	N/A ☐ GRAVITY ■ PRESSURE	☐ Basement w/plumbing		☐ Basement w/o plumbing	

Comments / Conditions: Install 50% Reduction on contour with PM disdtribution

Use 14 panels in each ditch (56 Total)
201.6 gallon dose - 2' pressure head * Use 1/2 sch 40 taps * 9.6 in drawdown

INITIAL SITE SKETCH

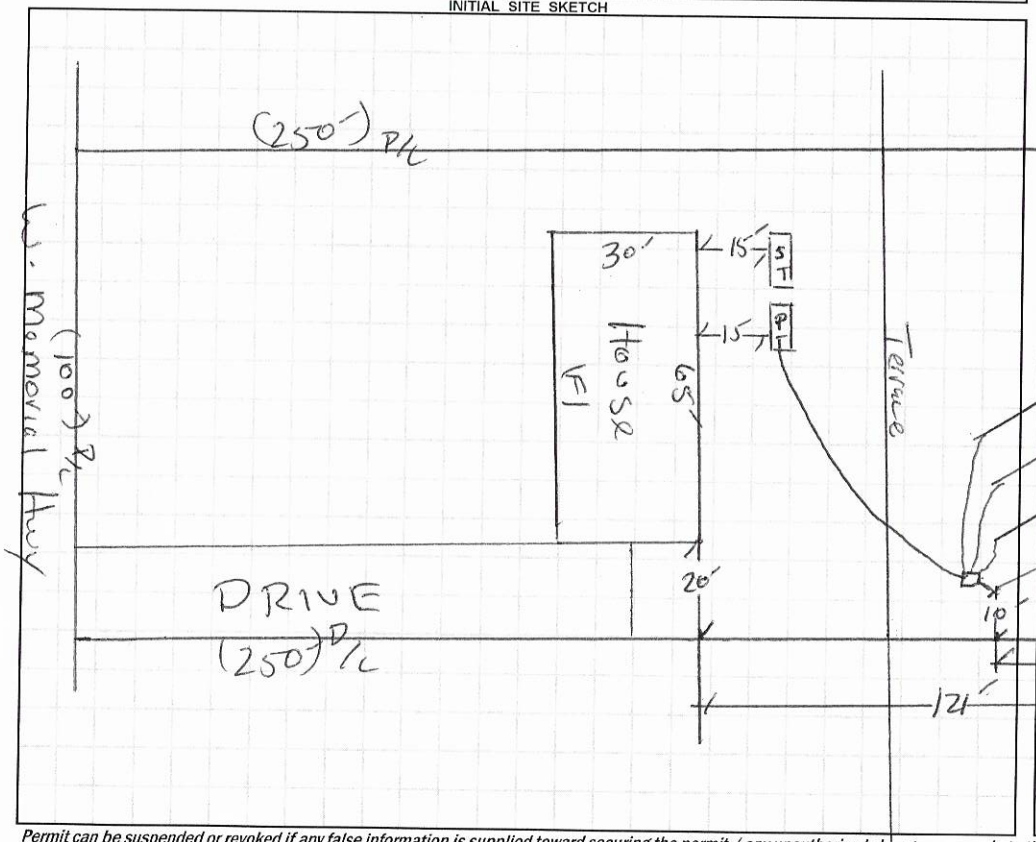

AS BUILT SKETCH

1" = 40

	Initials	Date
Drain Lines Checked		6-2-2021
Tanks Checked		6-2-2021
Pressure Manifold or Valve Box Checked		6-2-2021
Pressure Head Set		6-29-21
Electrical Checked		6-29-21
Floats Set		6-29-21
Alarm Checked		6-29-21
Maintenance Contract Y/(N)		6-29-21
Comments:		Not Required

Permit can be suspended or revoked if any false information is supplied toward securing the permit / any unauthorized changes are made to the site / any unauthorized changes are made in the installation of the system. **CONTACT A LOCATOR SERVICE PRIOR TO ANY EXCAVATION**

☐ **IMPROVEMENT PERMIT** *with plat valid without expiration.* ■ **IMPROVEMENT PERMIT** *with site plan valid for 60 mos.* ☐ **AUTHORIZATION TO CONSTRUCT** *valid for period equal to IMPROVEMENT PERMIT--not to exceed 60 mo.*

Owner / Applicant Signature: Date: 11/24/2020 Installed by: Piedmont Backhoe

IMPROVEMENT PERMIT by: Date: 11/20/2020 OPERATION PERMIT by: Date: 6-29-2021

AUTHORIZATION TO CONSTRUCT by: Date: 3/29/2021 Existing System Inspected by: Date:

FOR SEPTIC FINAL INSPECTION: CALL 704-664-3703 between 8am-9am the day the inspection is needed. Be sure to speak with an inpsector to confirm your inspection time.

DEPARTMENT OF HEALTH AND HUMAN SERVICES
DIVISION OF PUBLIC HEALTH, ENVIRONMENTAL HEALTH SECTION
ON-SITE WATER PROTECTION BRANCH

Sheet 1 of 1
PROPERTY ID #: 0671213284

SOIL/SITE EVALUATION
for ON-SITE WASTEWATER SYSTEM
(Complete all fields in full)

OWNER: Clayton Homes
ADDRESS: 2026 Wormside Dr
PROPOSED FACILITY: 3 BD
LOCATION OF SITE: Lot 22 344 W. Memorial Hwy
APPLICATION DATE: 9/28/20
DATE EVALUATED:
PROPERTY SIZE: 0.53 ac
PROPERTY RECORDED: Yes
PROPOSED DESIGN FLOW (.1949): 360

WATER SUPPLY: ☐ Private ☑ Public ☐ Well ☐ Spring ☐ Other N/A

EVALUATION METHOD: ☐ Auger Boring ☑ Pit ☐ Cut

TYPE OF WASTEWATER: ☑ Sewage ☐ Industrial Process ☐ Mixed

PROFILE #	.1940 LANDSCAPE POSITION/ SLOPE %	HORIZON DEPTH (IN.)	SOIL MORPHOLOGY (.1941)		OTHER PROFILE FACTORS				PROFILE CLASS & LTAR
			.1941 STRUCTURE/ TEXTURE	.1941 CONSISTENCE/ MINERALOGY	.1942 SOIL WETNESS/ COLOR	.1943 SOIL DEPTH	.1956 SAPRO CLASS	.1944 RESTR HORIZ	
1	L 5%	0-20	Gr SCL	fr SE	2.5 yr 7/2 @ 47"	PS	W/A	N/A	PS 1.25
		20-54	SBK C	fi SE					
2	L 5%	0-12	Gr SCL	fr SE	PS	PS	W/A	W/A	PS 1.25
		12-32	SBK C	fi SE					
		32-56	WABK BC	fi/fr SE					
3	L 3%	0-9	Gr SCL	fr SE	PS	51"	W/A	Rock mixed with C 9"-51" Greater than 50%	UNS
		9-51	Mass (C)	fi/vfi SE/E					
4	L 7%	0-9	Gr SCL	fr SE	PC	42"	42"	9"	UNS to 21"
		9-21	Mass C	fi SE/E					
		21-42	WABK DC	fi/fr SE					
		42-51	Mass Sap(C)	fr W/A					

DESCRIPTION	INITIAL SYSTEM	REPAIR SYSTEM
Available Space (.1945)	PS	PS
System Type(s)	III	
Site LTAR	0.25	

OTHER FACTORS (.1946): PS
SITE CLASSIFICATION (.1948): PS
EVALUATED BY: A Smith
OTHER(S) PRESENT:

COMMENTS:

LEGEND

use the following standard abbreviations

LANDSCAPE POSITION	GROUP	SOIL TEXTURE	CONVENTIONAL .1955 LTAR*	LPP .1957 LTAR*	MINERALOGY/ CONSISTENCE	STRUCTURE
CC (Concave Slope) CV (Convex Slope) D (Drainage Way) DS (Debris Slump) FP (Flood Plain) FS (Foot Slope) H (Head Slope) L (Linear Slope) N (Nose Slope) R (Ridge) S (Shoulder Slope) T (Terrace)	I	S (Sand) LS (Loamy Sand)	1.2 - 0.8	0.6 - 0.4	SEXP (Slightly Expansive) EXP (Expansive)	G (Single Grain) M (Massive) CR (Crumb) GR (Granular) SBK (Subangular Blocky) ABK (Angular Blocky) PL (Platy) PR (Prismatic)
	II	SL (Sandy Loam) L (Loam)	0.8 - 0.6	0.4 - 0.3		
	III	Si (Silt) SiCL (Silty Clay Loam) CL (Clay Loam) SCL (Sandy Clay Loam) SiL (Silt Loam)	0.6 - 0.3	0.3 - 0.15		
					MOIST	**WET**
	IV	SC (Sandy Clay) SiC (Silty Clay) C (Clay)	0.4 - 0.1	0.2 - 0.05	VFR (Very Friable) FR (Friable) FI (Firm) VFI (Very Firm v. Very Sticky) EFI (Extremely Firm)	NS (Non-sticky) SS (Slightly Sticky) S (Sticky) VS (Very Sticky) NP (Non-plastic) SP (Slightly Plastic) P (Plastic) VP (Very Plastic)
		O (Organic)	None	None		

*Adjust LTAR due to depth, consistence, structure, soil wetness, landscape, position, wastewater flow and quality.


NOTES

HORIZON DEPTH — In inches below natural soil surface
DEPTH OF FILL — In inches from land surface
RESTRICTIVE HORIZON — Thickness and depth from land surface
SAPROLITE — S(suitable) or U(unsuitable)
SOIL WETNESS — Inches from land surface to free water or inches from land surface to soil colors with chroma 2 or less - record Munsell color chip designation
CLASSIFICATION — S (Suitable), PS (Provisionally Suitable), or U (Unsuitable)

Evaluation of saprolite shall be by pits.

Long-term Acceptance Rate (LTAR): gal/day/ft²

Show profile locations and other site features (dimensions, reference or benchmark, and North).

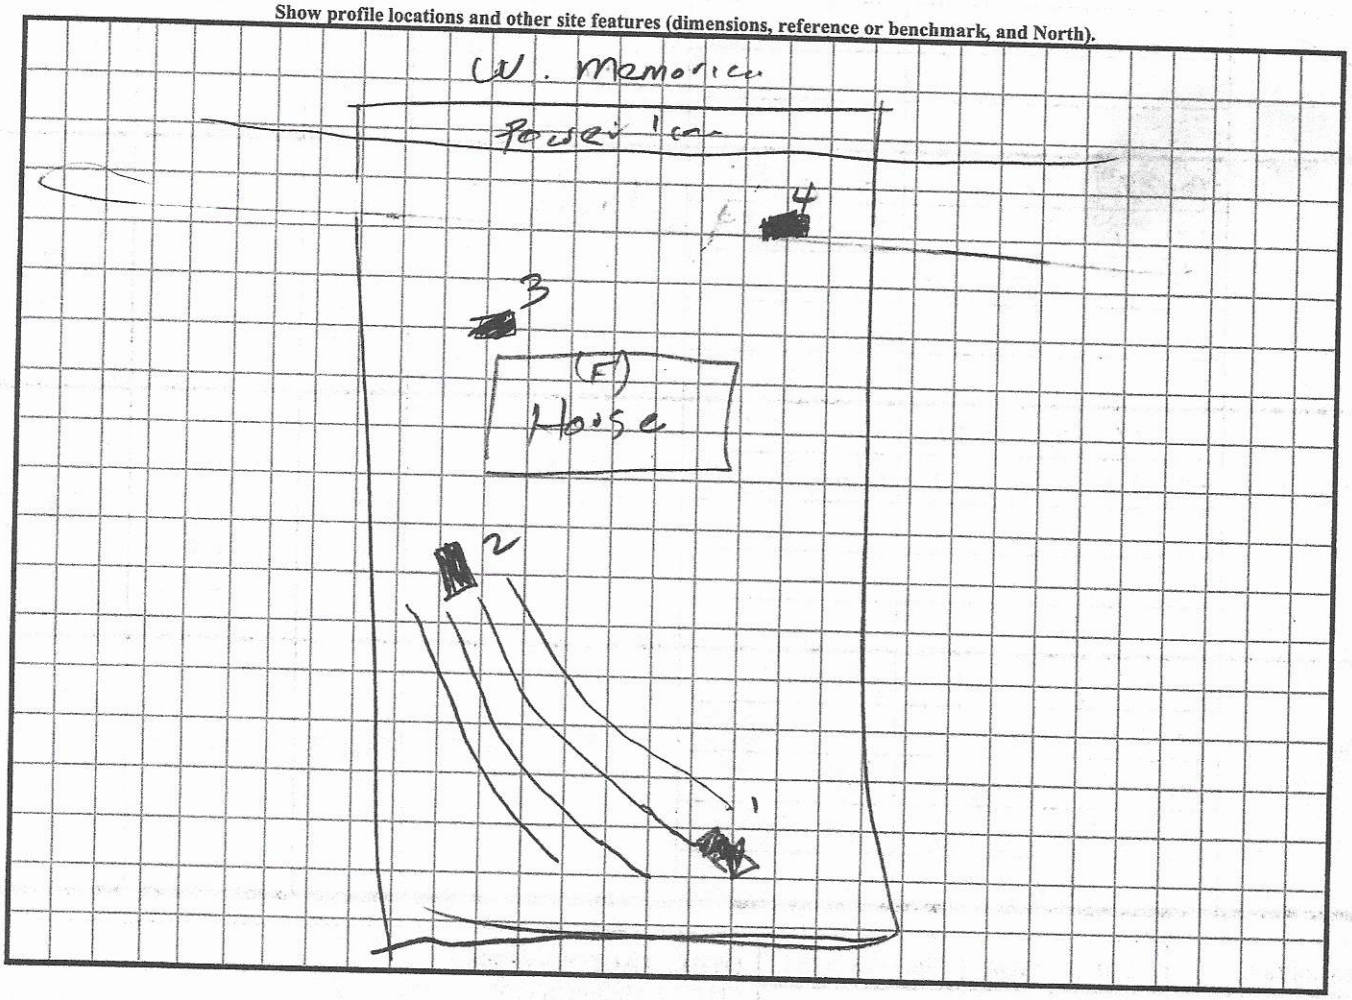

Pump to rear looking into Combining

RECEIVED OCT 02 2020

AP-311387
$500.00

APPLICATION MUST BE FILLED OUT COMPLETELY & BE LEGIBLE OR IT WILL NOT BE PROCESSED

Iredell County Health Department – Environmental Health Division

PAGE 1: *APPLICATION FORM*

Application For:

(X) Septic Improvement Permit ( ) New Well Permit (X) Authorization to Construct ( ) Well Repair Permit ( ) Existing System Inspection ( ) Well Abandonment ( ) Septic System Repair

THE ABOVE PERMIT DOCUMENTS WILL BECOME INVALID IF INFORMATION PROVIDED ON THIS APPLICATION IS FALSIFIED OR CHANGED, OR IF THE SITE IS ALTERED. THE IMPROVEMENT PERMIT IS VALID FOR EITHER 60 MONTHS OR WITHOUT EXPIRATION DEPENDING UPON DOCUMENTATION SUBMITTED. APPLICATION WITH SITE PLAN 60 MONTHS, APPLICATION WITH COMPLETE, SCALED PLAT WITHOUT EXPIRATION. SEE 15A NCAC 18A .1937(f) FOR DETAILS.

Page 2: *Site Plan Worksheet* form MUST accompany this application

The following optional attachments may also be submitted: ( ) Survey Plat, scaled no more than 1 inch = 60 feet

Place an (X) beside whichever is submitted if applicable (X) Custom Site Plan, scaled no more than 1 inch = 60 feet

Applicant Information: (PRINT CLEARLY)

Applicant Name: CLAYTON HOMES Address: 2026 NORTHSIDE DR.

Applicant Email: HC072@CLAYTONHOMES.COM Phone: STATESVILLE NC Zip: 28625

Owner Name: KEILER LEGACY TR. Phone: 704-873-2547 Alt. Phone: 704-902-4659

Owner Email: Address: 908-C DAVIE AVE STATESVILLE Zip: 28677

Phone: Alt. Phone:

Property Information:

Street Address: TBD WEST MEMORIAL HWY 344 W. Memorial Hwy

Subdivision Name: Section/Phase: Lot Number: 22

Driving Directions: 77 North, (R) on 901 Site on Left Across from 341 West Memorial Hwy

Site Development Information: *(check or complete ALL that apply*

(X) New Single Family Residence
( ) New Multi-Family Residence
( ) Accessory Building
( ) Bedroom(s) Addition
( ) Repair to failing septic system ___ Tank ___ Drain lines Describe Problem:

Maximum Number of Bedrooms: 3
Maximum Number of Occupants: 5
( ) Swimming Pool
( ) Other Addition/Structure:

CHECK FOUNDATION TYPE

(X) Crawl Space Foundation
( ) Concrete Slab Foundation
( ) Basement with Plumbing
( ) Basement without Plumbing

Non-Residential Site Development: Type of Business:

Square Footage of Building: Max. Number of Employees: Max. Number of Seats/Beds/Other:

Water Supply: ( ) Replacement Well – Reason:

( ) Multi-connection Well Number of Houses: Number of Persons:

( ) New Well ( ) Existing Well ( ) Community Well ( ) City Water (X) Other Public Water

Desired Septic System Type: *(you may rank in order of preference)* Year existing system installed:

( ) No Preference ( ) Alternative (X) Conventional ( ) Innovative ( ) Modified Conventional (X) Other: 25%

Please answer the following to the best of your ability:

( ) Yes (X) No Does the site contain any jurisdictional wetlands?
( ) Yes (X) No Is any non-domestic sewage (i.e. industrial) to be generated?
( ) Yes (X) No Is the site subject to approval by any other public agency?

I have read this application and certify that the information provided herein is true, complete, and correct. Authorized county and state officials are granted right of entry to conduct necessary inspections to determine compliance with applicable laws and rules. I understand that I am solely responsible for the proper identification and labeling of all property lines and corners and making the site accessible so that a complete site evaluation can be performed.

Signature: (LAMIE) 9/28/20

Property owner or owner's legal representative signature (SIGNATURE REQUIRED) DATE

DocuSign Envelope ID: 4AEAF559-AF10-485B-B31C-0B162F6A5E10

IREDELL COUNTY DEPARTMENT OF ENVIRONMENTAL HEALTH

DOCUMENTATION TO AUTHORIZE AN OWNER'S LEGAL REPRESENTATIVE

(Check and sign only ONE of the options below)

☐ 1. *** APPLICANT AND OWNER ARE THE SAME. *** (*Sign here*) _____

Applications for permits require the "signature of the owner or owner's legal representative" (15A NCAC 18A .1937). If the owner does not sign the application himself or herself, they can submit any one of the following documents to designate their legal representative: *Power of Attorney; Real Estate Contract; Estate executor; Bankruptcy trustee; Court ordered guardianship*
In the absence of the above documentation, the property owner may provide the local health department with documentation that designates a legal representative. A property owner may:
Complete this form to document his or her legal representative, or provide his or her own form that contains the information in this form. If there are multiple property owners, then all property owners must sign the form that designates a legal representative.
By signing a form that designates a legal representative for purposes of 15A NCAC 18A .1937, the property owner authorizes that representative to act on their behalf in matters pertaining to the application and permitting process, including signing or receiving any application, document or permit. The owner retains full responsibility to meet all permit conditions specified by the local health department.

☐ 2. DocuSigned by: ANN CAMPBELL 7FB2B4E44E4046D... am the legal owner(s) of the property located at W. MEMORIAL HWY HARMONY NC, identified as PIN (Parcel Identification Number) 4871213289, located in Iredell County, North Carolina.

I do hereby authorize (print legal representative/company name) CANTON HOMES LANE HARRELL, ADAM CASSTEVENS to act as an agent on my behalf in applying for/signing/obtaining any of the documents described below.

- Application for Improvement Permit (IP) / Authorization to Construct (AC)
- Improvement Permit (IP) / Authorization to Construct (AC)
- Application for soil-site evaluation (new/repair)
- Application/permit for private drinking water well/well abandonment
- Application for Compliance Inspection

I agree to abide by all decisions and/or conditions between the legal representative acting on my behalf and the Iredell County Department of Public Health, Environmental Health Division.

DocuSigned by: ANN CAMPBELL 7FB2B4E44E4046D... Signature of Owner(s)


9/29/2020 | 12:57:27 PM PDT Date

Mooresville - Environmental Health
Fax: 704-662-3239
610 E. Center Avenue, Mooresville, NC 28115

Statesville - Environmental Health
ronda.hart@co.iredell.nc.us
Fax: 704-871-3483
349 N. Center Street, Statesville, NC 28677

IREDELL COUNTY HEALTH DEPARTMENT
ENVIRONMENTAL HEALTH DIVISION
PAGE 2: *SITE PLAN WORKSHEET*

SEE THE "SAMPLE SITE PLAN" BELOW. *INCOMPLETE SITE PLANS WILL BE RETURNED TO YOU FOR COMPLETION AND MAY RESULT IN A DELAY IN THE ISSUANCE OF YOUR SEPTIC SYSTEM PERMIT!!!*

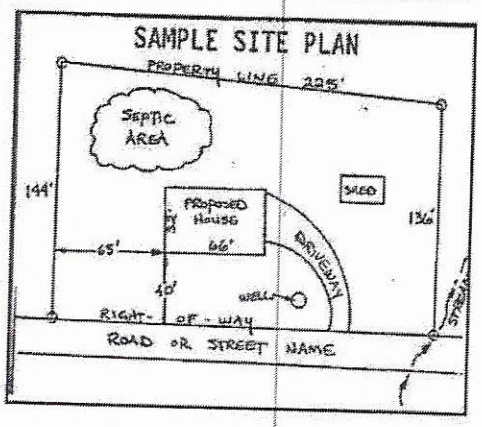

Place an (X) beside each item as you complete the site plan:

- (X) Property Line measurements are clearly identified
- (X) All proposed structures are indicated
- (X) Front and side setbacks from property line
- (X) Preferred driveway location and well location
- (X) Area you prefer your septic system to be placed
- (X) North arrow, or other sufficient indicator of direction

Circle N/A on the following if appropriate:

Location of septic systems and wells within 100' of your property	N/A
Location of easements and rights of ways on your property	N/A
Location of any designated wetlands on the property	N/A

USE THIS SPACE TO DRAW YOUR SITE PLAN


Show: proposed house or business footprint, wells, water lines, patios, pools and decks, and any other item that will occupy space on the site

SEE ATTACHED

Signature: _____
Property owner or owner's legal representative signature (SIGNATURE REQUIRED)


9/28/2022
DATE

LOT 22

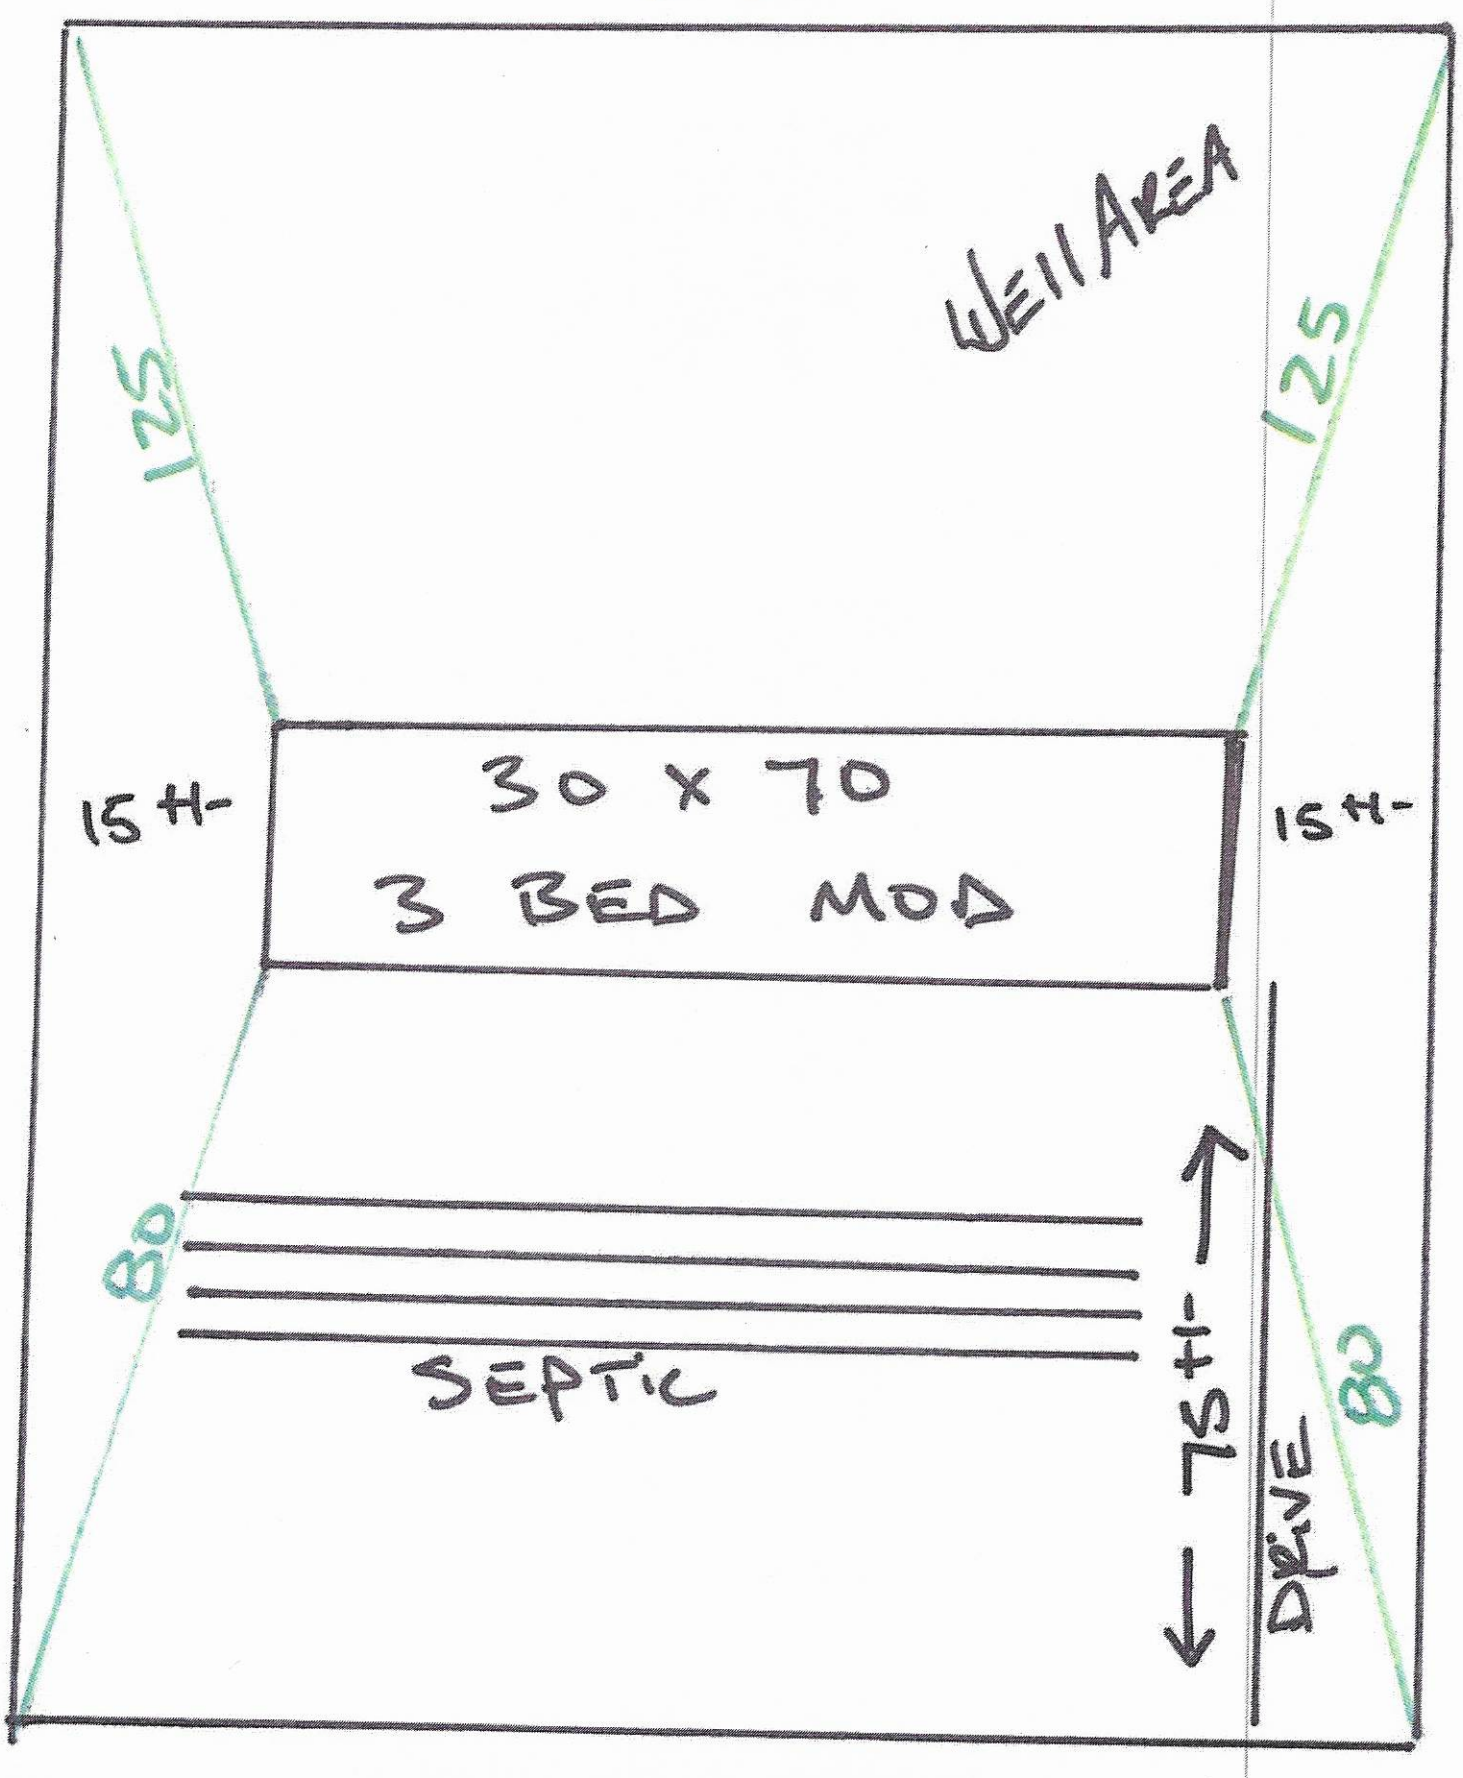
WELL AREA
125
125
15 H-
30 x 70
3 BED MOD
15 H-
80
SEPTIC
DRIVE

LOT 22, 23, & 24


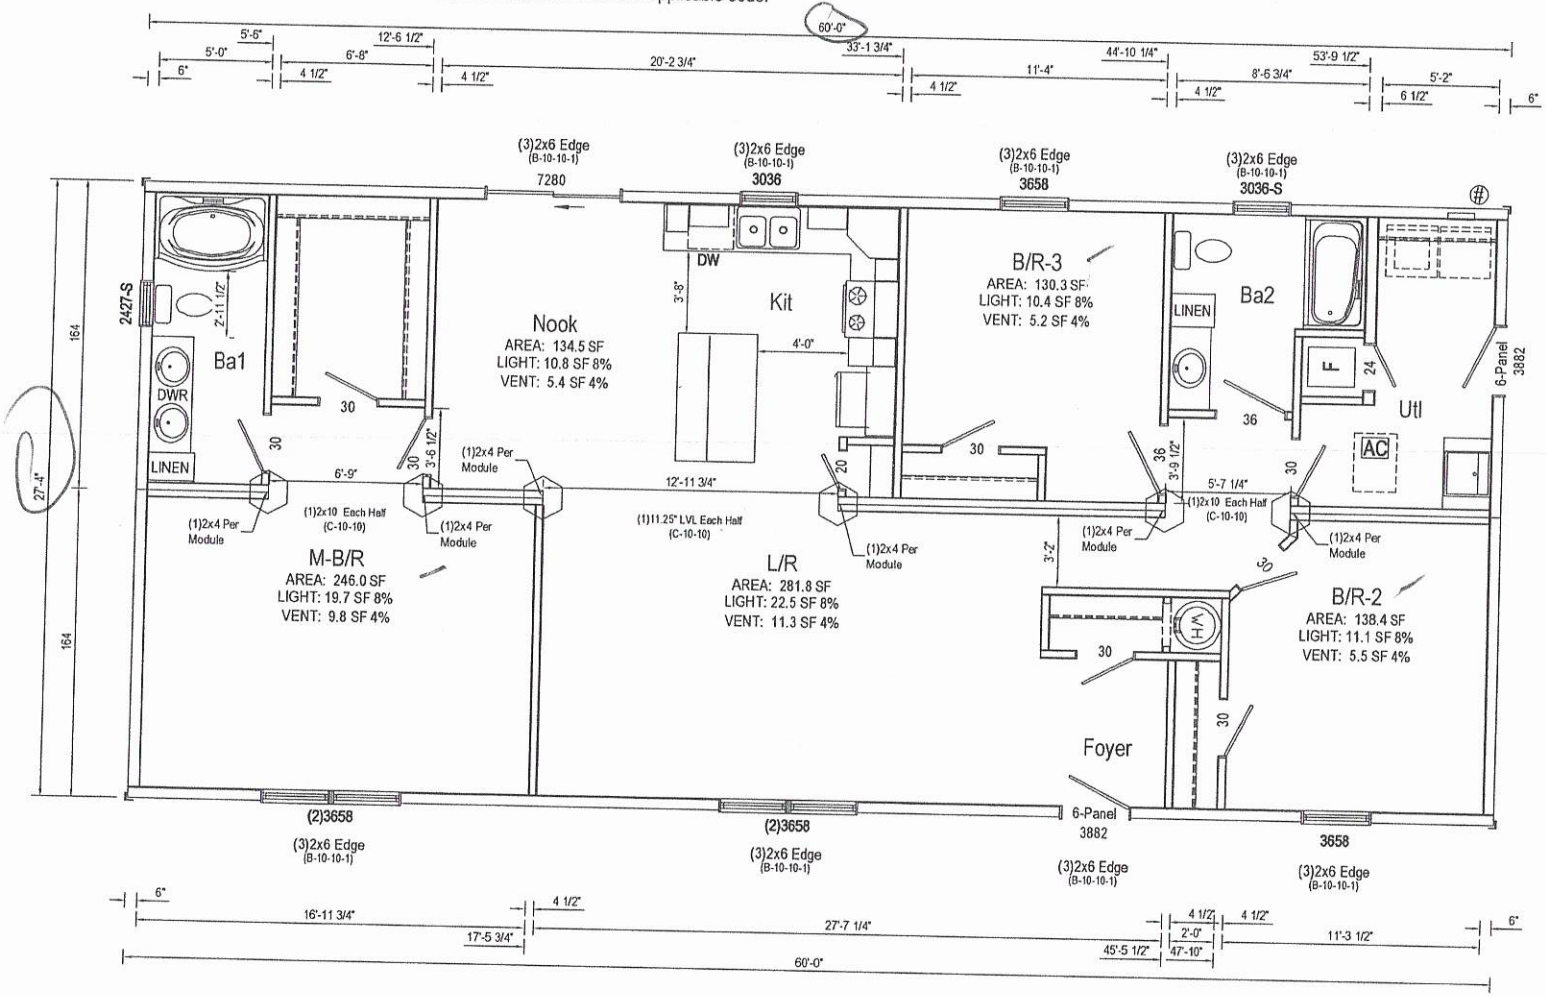

Acknowledgement Of Plans Submittal ONLY! Date 3-17-21 Date 3-24-21

See Schedules and General Notes Page
⬡ = Column Support Location
AC = Attic Access

Note:
* LVLs noted must extend past column on at least one end 24" minimum and be overlayed with OSB sheathing.

Notes:
1. Exterior opening headers and jack studs are SPF #2 unless otherwise noted.
2. Sidewall headers may use alternate construction per section B-10 of Systems Manual.
3. LVL's where specified to be minimum of 1 1/2" wide, M.O.E. = 2.0 and fb = 2900 PSI.
4. See C-10-45 for stair opening framing.
5. See C-10-105 for dormer opening framing.

APPROVED BY NTA 11/10/2020
Approval of this document does not authorize or approve any deviation or deviations from the requirements of applicable State Laws
Kip Whitehead

Builder: R-Anell Housing Group, LLC - Subsidiary of The Commodore Corp.
Title: Floor Plan

Callout	Revisions	Scale	Date	Cust: SPEC 901-3	Model/Eng No.
2800		3/16" = 1'-0"	11/06/2020	Dir: CLAYTON STATESVILLE	1BL1002-RB13
	Drawn By: NE	Reference: NONE		S/N: 42794	Pg: FP

IREDELL COUNTY · NC

IREDELL COUNTY
PO Box 788
349 North Center St.
Statesville, NC 28677

APPLICATION NUMBER
311387 Issue Date: 09/30/2020

Permit Type: ZONING

Parcel Number	Street Address	Jurisdiction
4871213289.000		IREDELL COUNTY

Owner Information	Applicant Information
Name: KELLER LEGACY TR Address: , Phone:	Name: CLAYTON HOMES OF STATESVILLE Address: 2026 NORTHSIDE DR STATESVILLE, NC 28677 Phone: (704)873-2547

Use Requested	Zone Code
Modular	RA

Lot Acreage	F Setback	B Setback	L Setback	R Setback	Watershed	Flood Zone
0.53	35	35	15	15	N/A	NO

Remarks
MODULAR - 344 W MEMORIAL

The applicant certifies that there are no deed restrictions, contractual agreements or governmental regulations of any kind that interfere with or prohibit the use of the property or the use for which this permit is requested. The applicant further acknowledges that enforcement of deed restrictions, plat conditions and other contractual agreements will not be undertaken by Iredell County and is the sole responsibility of the affected parties.


_____
Signature of Owner/Contractor

Date: 09/30/2020

Permit Number	311387

TOTAL FEES:	$77.25

ZONING DISCLAIMER

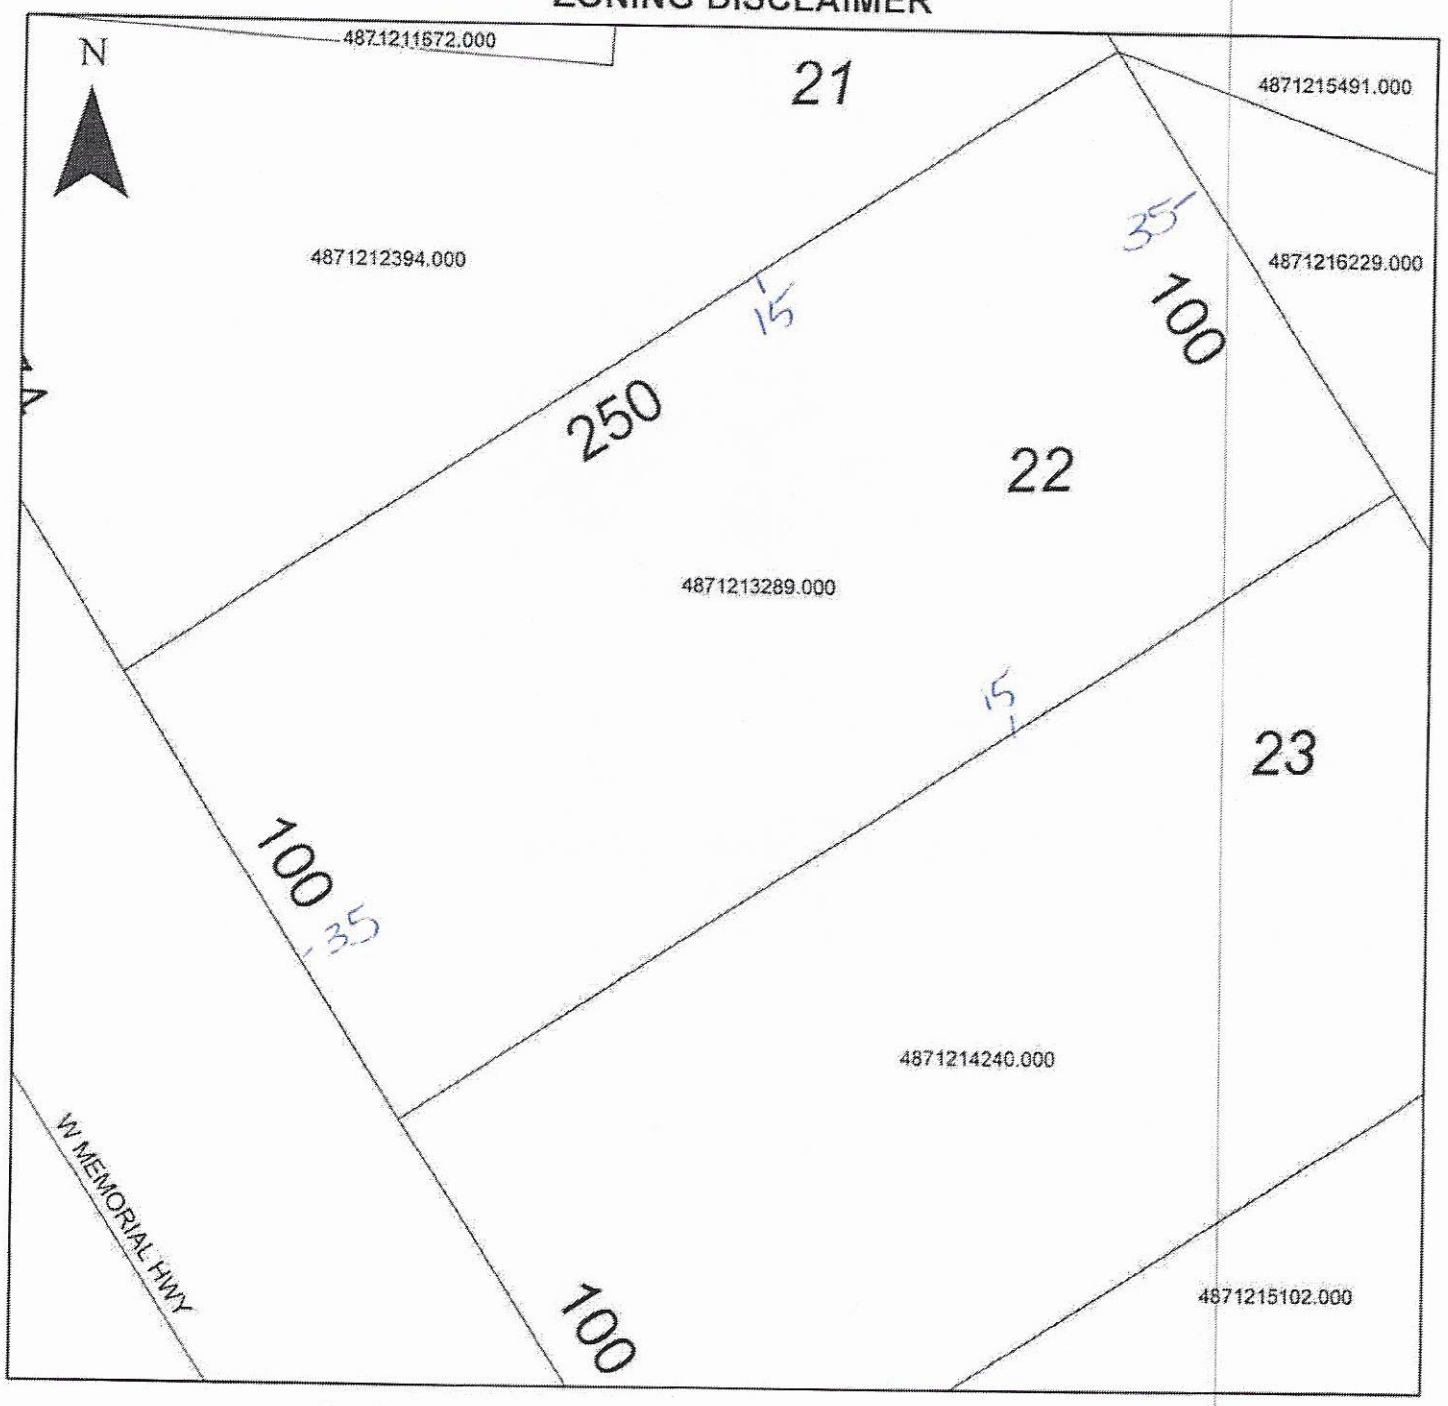

Property Address 344 W Memorial

The applicant certifies that there are no deed restrictions, contractual agreements or governmental regulations of any kind that interfere with or prohibit the use of the property or the use for which this permit is requested. Applicant further acknowledges that the enforcement of deed restrictions, plat conditions, and other contractual agreements will not be undertaken by Iredell County and is the sole responsibility of the affected parties.

Kent Wells
Applicant

9-30-2020
Date