IREDELL COUNTY HEALTH DEPARTMENT

STATESVILLE 704-878-5305 MOORESVILLE 704-664-5281

IMPROVEMENT PERMIT / AUTHORIZATION TO CONSTRUCT / OPERATION PERMIT / EXISTING SYSTEM INSPECTION

PERMIT # 166149 PIN # 4871 23 0115 DATE May 17, 2011

OWNER or APPLICANT Kenneth Grant PHONE: Business 704 902 4708 Home:

OWNER or APPLICANT ADDRESS 111 Bristol Rd. Statesville

LOCATION / DIRECTIONS I77N EXIT to Hwy 901 TR 901 E 3.7 miles TL Little Wilkesboro Rd .1 mile on left (# 380 Little Wilkesboro Rd

SUBDIVISION BLOCK / SECTION LOT # LOT AREA 37AC DESIGN FLOW 600 gpd L.T.A.R. 3 initial sys / .25 Repa

Septic Tank 1500 Gallons: STB Date

Pump Tank Gallons: P T Date

Pump Make Model Serial #

Nitrification Field No Fields 1 No Lines 4 CF Linear Feet 667

Trench Width 36" Max. Trench Bottom Depth 36" Gravel Depth 12"

☒ New System ☐ Repair ☐ Expansion System Type I (II) III IV V VI

System Description: Gravity Conventional

Repair System Description: Gravity conventional

Maintenance Agreement Required ☐ YES ☒ NO

☒ GRAVITY ☐ PRESSURE

☒ Residence No. Bedrooms 5

☐ Business No. Persons

☐ Other No. Employees


☐ Slab ☐ Crawl Space

☒ Basement w/plumbing ☐ Basement w/o plumbing

Water Supply: ☒ Private ☐ Public ☐ Community

Comments / Conditions

INITIAL SITE SKETCH NTS

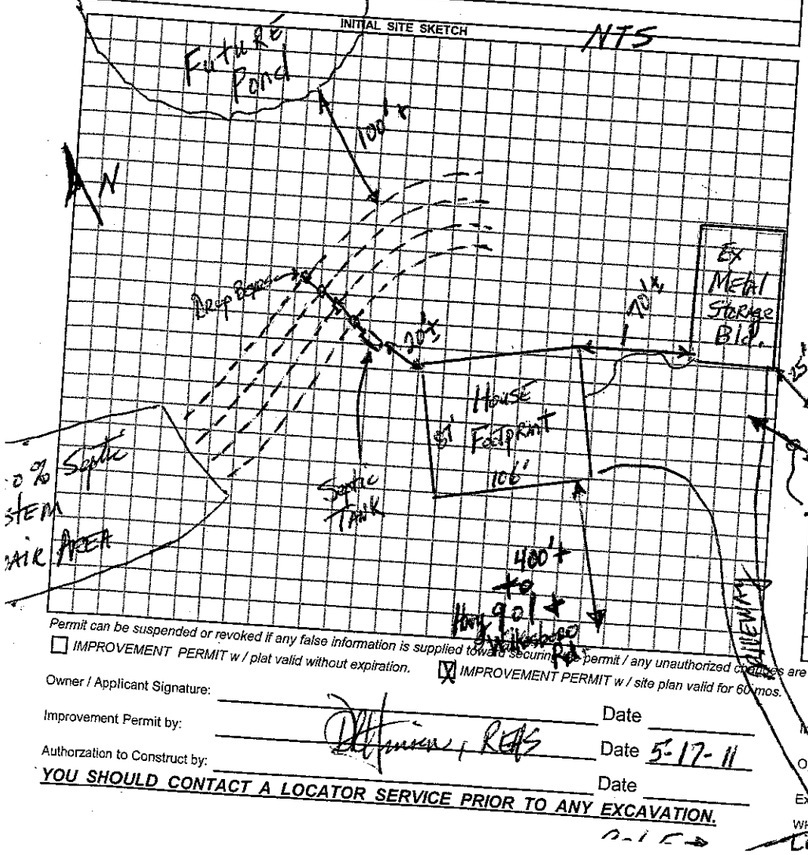

Comments / Conditions

AS BUILT SKETCH

OWES

NEEDS floor plan for AC

Permit can be suspended or revoked if any false information is supplied toward securing the permit / any unauthorized changes are made to the site / any unauthorized changes are made in the installation of the system.

☐ *IMPROVEMENT PERMIT w / plat valid without expiration.* ☒ *IMPROVEMENT PERMIT w / site plan valid for 60 mos.* ☐ *AUTHORIZATION TO CONSTRUCT valid for period equal to IMPROVEMENT PERMIT-not to exceed 60 mo.*

Owner / Applicant Signature: Date

Improvement Permit by: Date 5-17-11

Authorization to Construct by: Date

Installed by:

Operation Permit by: Date:

Existing System Inspected by: Date:

YOU SHOULD CONTACT A LOCATOR SERVICE PRIOR TO ANY EXCAVATION.

WHITE COPY (Final) Environmental Health YELLOW COPY (Final) Owner / Applicant PINK COPY (Initial) Owner / Applicant