IREDELL COUNTY HEALTH DEPARTMENT

STATESVILLE 704-878-5305 MOORESVILLE 704-664-5281

IMPROVEMENT PERMIT / AUTHORIZATION TO CONSTRUCT / OPERATION PERMIT / EXISTING SYSTEM INSPECTION

PERMIT # 16614 9 PIN # 4871 23 0115 DATE May 17 2011

OWNER or APPLICANT Kenneth Grant PHONE: Business 704 902 4388 Home:

OWNER or APPLICANT ADDRESS 111 Bristol Rd. Statesville


LOCATION / DIRECTIONS I77N Exit to Hwy 901 TR 901 E 3.7 miles TL Little Wilkesboro Rd .1 mile on left (# 380 Little Wilkesboro Rd.)

SUBDIVISION BLOCK / SECTION LOT # LOT AREA 3.7AC DESIGN FLOW 600 gpl L.T.A.R. .3 in/min sys / .25 Repair

Septic Tank 1500	Gallons: STB 528	Date 3-8-14	☒ New System ☐ Repair ☐ Expansion System Type I II III IV V VI	☒ Residence No. Bedrooms 5	Water Supply ☒ Private
Pump Tank N/A	Gallons: PT N/A	Date N/A	System Description: ~~Conventional~~ Conventional 25%	☐ Business No. Persons	☐ Public
Pump Make N/A	Model Tuf-Flo N	Serial # EF-4	Repair System Description: Conventional	☐ Other No. Employees	☐ Community
Nitrification Field No Fields 1	No Lines 4 CF Linear Feet 600		Maintenance Agreement Required ☐ YES ☒ NO	☐ Slab ☐ Crawl Space	
Trench Width 36"	Max. Trench Bottom Depth 36"	Gravel Depth 12"	☒ GRAVITY ☐ PRESSURE	☒ Basement w/plumbing ☐ Basement w/o plumbing	


Comments / Conditions

INITIAL SITE SKETCH NTS

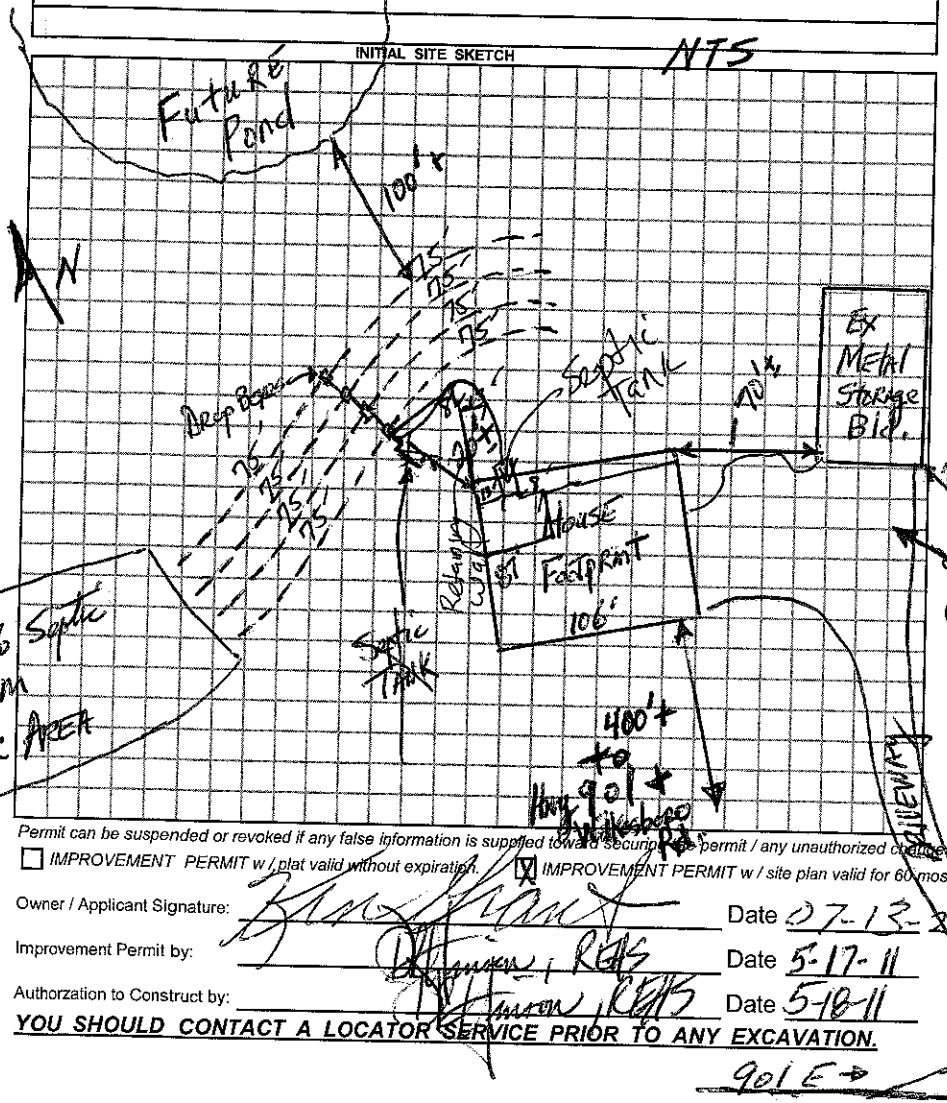

Comments / Conditions

AS BUILT SKETCH

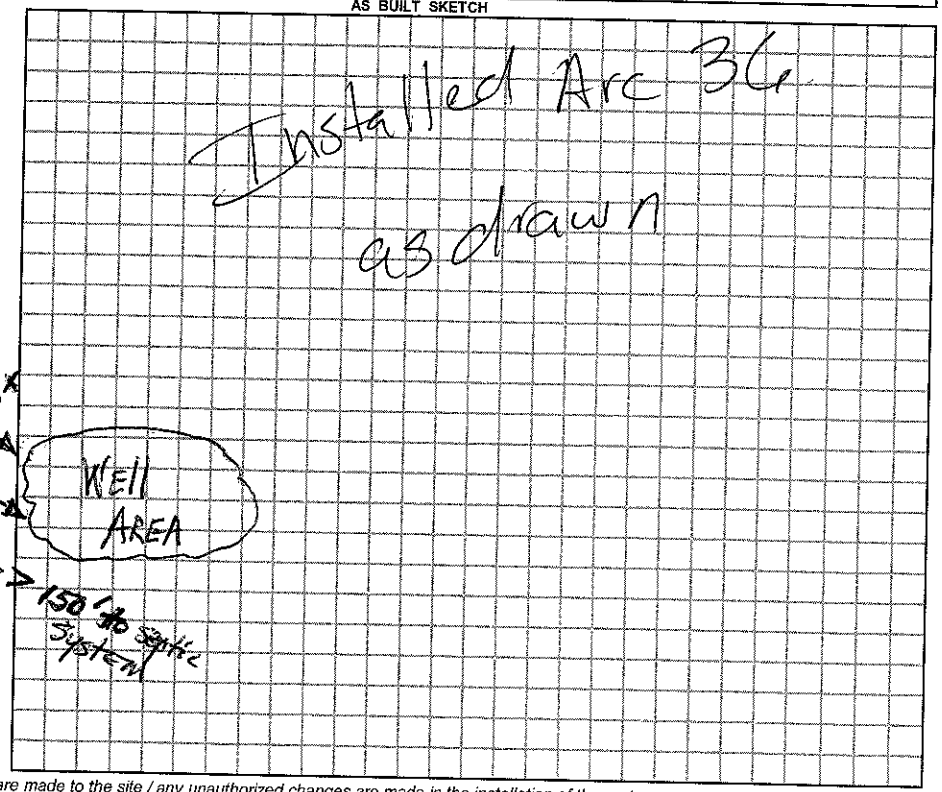

Permit can be suspended or revoked if any false information is supplied toward securing the permit / any unauthorized changes are made to the site / any unauthorized changes are made in the installation of the system.

☐ IMPROVEMENT PERMIT w / plat valid without expiration. ☒ IMPROVEMENT PERMIT w / site plan valid for 60 mos. ☐ AUTHORIZATION TO CONSTRUCT valid for period equal to IMPROVEMENT PERMIT-not to exceed 60 mo.

Owner / Applicant Signature: Date 07-13-20 Installed by: Steve Jordon

Improvement Permit by: Date 5-17-11

Authorization to Construct by: Date 5-18-11

Operation Permit by: Date: 06/11/14

Existing System Inspected by: Date:

YOU SHOULD CONTACT A LOCATOR SERVICE PRIOR TO ANY EXCAVATION.

WHITE COPY (Final) Environmental Health YELLOW COPY (Final) Owner / Applicant PINK COPY (Initial) Owner / Applicant