IREDELL COUNTY HEALTH DEPARTMENT

STATESVILLE 704-878-5305 MOORESVILLE 704-664-5281

IMPROVEMENT PERMIT / AUTHORIZATION TO CONSTRUCT / OPERATION PERMIT / EXISTING SYSTEM INSPECTION

PERMIT# REPAIR PIN# DATE 1-25-00

OWNER OR CONTRACTOR ANDREW DAWSON PHONE: Business Home 546-5101

ADDRESS 297 LITTLE WILKESBORO ROAD, HARMONY, NC 28634

LOCATION US 21 N. TL LITTLE WILKESBORO RD, LOT ON LEFT AT BOX # 297

SUBDIVISION BLOCK / SECTION LOT LOT AREA AMPLE SITE CLASS. P3 DESIGN FLOW 360 L.T.A.R. EXISTING

Septic Tank: EXISTING Gallons: STB Date

Pump Tank: Gallons: PT Date

Pump Make: Model Serial No

Nitrification Field: No Fields 1 Square Feet 360 Linear Feet 120

No Lines ONE Trench Width 36" Max Trench Bottom Depth As Surveyed Gravel Depth 24"

☐ New System ☑ Repair System Type: I (II) III. IV. V. VI

System Description: CONVENTIONAL GRAVITY

Repair System Description: CONV. GRAVITY

Maintenance Agreement Required: ☐ Yes ☑ No

☑ House/Mod. Home No. Bedrooms 3

☐ Mobile Home No. Bathrooms 3.5

☐ Business No. Employees

☐ Other


☐ Slab ☑ Crawl Space ☐ Basement w/plumbing ☐ Basement wo/plumbing

Water Supply: ☐ Individual ☑ Public ☐ Community

Comments/Conditions: (1) INSTALL NEW DISTRIBUTION BOX REPLACING "BULL RUN" VALVE (2) INSTALL NEW 3" x 120' LINE USING 24" STONE INTERCEPTING OLD LINE AS SHOWN

Comments/Conditions: SEPTIC TANK PUMPED 1-28-00

INITIAL SITE SKETCH

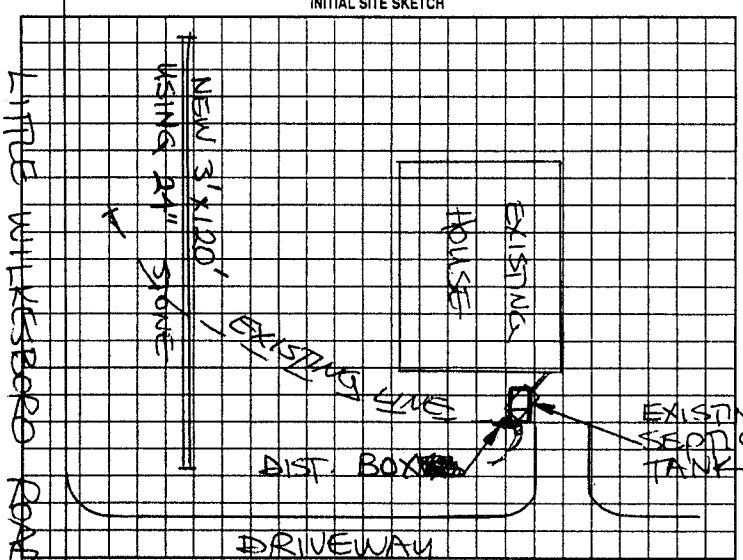

AS BUILT SKETCH

SYSTEM REPAIRED ACCORDING TO INITAL SITE SKETCH

Permit can be suspended or revoked if any false information is supplied toward securing the permit/any unauthorized changes are made to the site/any unauthorized changes are made in the installation of the system. Improvement Permit with plat valid without expiration. Improvement Permit with site plan valid for sixty months. Authorization to Construct is valid for a period equal to that of Improvement Permit – not to exceed sixty months.

Signed: date 01/25/00 Installed by: TOMMY FRYE

Improvement Permit by: STEVE HEDRICK date 1-25-00 Operation Permit by: STEVE HEDRICK date 2-3-00

Authorization to Construct by: STEVE HEDRICK date 1-25-00 Existing System Inspection by: date

HEALTH DEPT. COPY: WHITE OWNER COPY (FINAL): YELLOW OWNER COPY (INITIAL): PINK