IREDELL COUNTY HEALTH DEPARTMENT

Statesville Phone TR 3-7271 Mooresville Phone NO 3-1271

PERMIT TO INSTALL SEPTIC TANK

Permit No. 139 Permit Date 6-23 1972

Owner Hope Bros Builders Inc Address Statesville, NC

Installed By Hope Bros. Address Statesville, NC


Location of Property Harmony — left on Rt # 1840 at Harmony School - Go 1 mile 2 story House on Left —

| Tank | | Capacity | | Length of Lines | | Fixtures | |
|---|---|---|---|---|---|---|---|
| Block | ( ) | 1000 | ( 4 ) | 225' | ( 4 ) | No. of Baths | ( 1 ) |
| Precast | ( ✓ ) | 1250 | ( ) | 250' | ( ) | Dishwasher | ( ) |
| | | 1500 | ( ) | Other | | Garbage Grdr. | ( ) |
| | | Other | | | | Other | |

NOTIFY HEALTH DEPARTMENT AT LEAST EIGHT HOURS BEFORE TANK IS TO BE INSPECTED.

Final Inspection 6-23 1972 Approved ( ✓ ) Disapproved ( )

Remarks Iredell Water Supply —

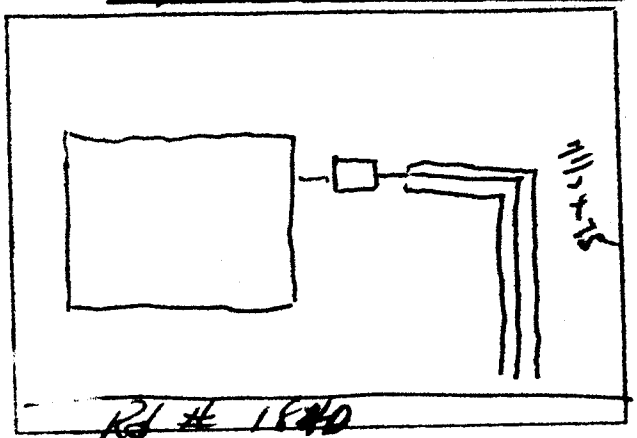


Sketch of Installation

Sanitarian