IREDELL COUNTY HEALTH DEPARTMENT

STATESVILLE 704-878-5305 MOORESVILLE 704-664-5281

IMPROVEMENT PERMIT / AUTHORIZATION TO CONSTRUCT / OPERATION PERMIT / EXISTING SYSTEM INSPECTION

PERMIT# HARMONY 794/99 PIN# DATE 12-7-98

OWNER OR CONTRACTOR HUNTING CREEK BUILDING COMPANY PHONE Business 539-5539 Home

ADDRESS 1000 UNION GROVE ROAD, UNION GROVE, NC 28689

LOCATION US 21 N, TL LITTLE WILKESBORO ROAD, 5TH LOT ON RIGHT PAST RABBIT HIGHWAY

SUBDIVISION HARMONY COUNTRY BLOCK / SECTION LOT 6 LOT AREA 0.580 ACRE SITE CLASS PS DESIGN FLOW 360 L.T.A.R. 0.30 GPD/FT2

Septic Tank: 1000 Gallons: STB 319 Date 11-1-99
Pump Tank: Gallons: PT Date
Pump Make: Model Serial No
Nitrification Field: No Fields 1 Square Feet 1200 Linear Feet 400
No Lines FIVE Trench Width 36" Max Trench Bottom Depth 36" Gravel Depth 12"

✓ New System Repair System Type: CONVENTIONAL
System Description CONVENTIONAL GRAVITY
Repair System Description CONV. GRAVITY
Maintenance Agreement Required: Yes ✓ No

✓ House/Mod. Home No. Bedrooms 3
Mobile Home No. Bathrooms 2
Business No. Employees
Other


Water Supply: ☐ Individual ✓ Public ☐ Community

Site: ✓ Crawl Space Basement w/plumbing Basement w/o plumbing

Comments/Conditions:

Comments/Conditions

SCALE: 1" = 40' INITIAL SITE SKETCH

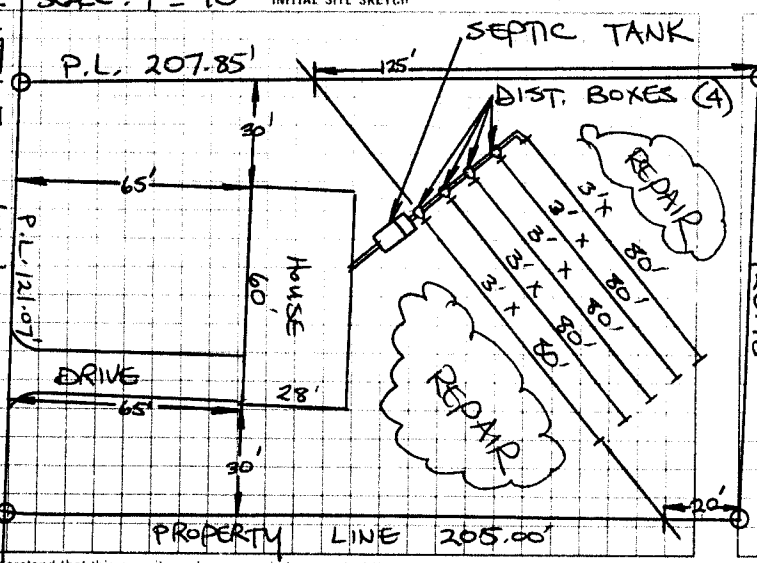

AS BUILT SKETCH

SYSTEM INSTALLED ACCORDING TO INITAL SITE SKETCH

I understand that this permit can be suspended or revoked if any false information is supplied toward securing the permit/any unauthorized changes are made to the site/any unauthorized changes are made in the installation of the system. Improvement Permit with plat valid without expiration. Improvement Permit with site plan valid for sixty months. Authorization to Construct is valid for a period equal to that of Improvement Permit – not to exceed sixty months.

(SR 1840)

Signed: Jennifer Winkler date 12-9-98 Installed by: DAVID UMBARGER

Improvement Permit by: STEVE HEDRICK date 12-7-98 Operation Permit by: STEVE HEDRICK date 12-13-99

Authorization to Construct by: STEVE HEDRICK date 12-7-98 Existing System Inspection by: date

HEALTH DEPT COPY WHITE INSPECTION COPY (FINAL) GREEN OWNER COPY (FINAL) YELLOW INSPECTION COPY (INITIAL) PINK OWNER COPY (INITIAL) GOLD