IREDELL COUNTY HEALTH DEPARTMENT

STATESVILLE 704-878-5305 MOORESVILLE 704-664-5281

IMPROVEMENT PERMIT / AUTHORIZATION TO CONSTRUCT / OPERATION PERMIT / EXISTING SYSTEM INSPECTION

PERMIT# REPAIR PIN# DATE 3-22-99

OWNER OR CONTRACTOR JIM MULLINS PHONE: Business Home 546-5301

ADDRESS P.O. BOX 60, HARMONY, NC 28634

LOCATION US 21 NORTH, TL LITTLE WILKESBORO ROAD, ON RIGHT AT BOX # 258

SUBDIVISION BLOCK / SECTION LOT LOT AREA AMPLE SITE CLASS PS DESIGN FLOW 360 L.T.A.R. EXISTING

Septic Tank: [redacted] Gallons; STB Date

Pump Tank: EXISTING Gallons; PT Date

Pump Make: Model Serial No

Nitrification Field: No Fields 1 Square Feet 975 Linear Feet 325

No Lines FOUR Trench Width 36" Max Trench Bottom Depth 36" Gravel Depth 12"

☐ New System ☑ Repair System Type: I II III IV V VI

System Description: CONVENTIONAL GRAVITY

Repair System Description: CONV. GRAVITY

Maintenance Agreement Required: ☐ Yes ☑ No

☑ House/Mod. Home No. Bedrooms 3

☐ Mobile Home No. Bathrooms 2

☐ Business No. Employees

☐ Other


☐ Slab ☑ Crawl Space ☐ Basement w/plumbing ☑ Basement wo/plumbing

Water Supply: ☐ Individual ☑ Public ☐ Community


Comments/Conditions: ① ABANDON EXISTING LINES
② THIS PERMIT SERVES AS NOTICE OF VIOLATION
③ TIE WASHER & SINK DRAIN INTO SEPTIC TANK

Comments/Conditions

INITIAL SITE SKETCH

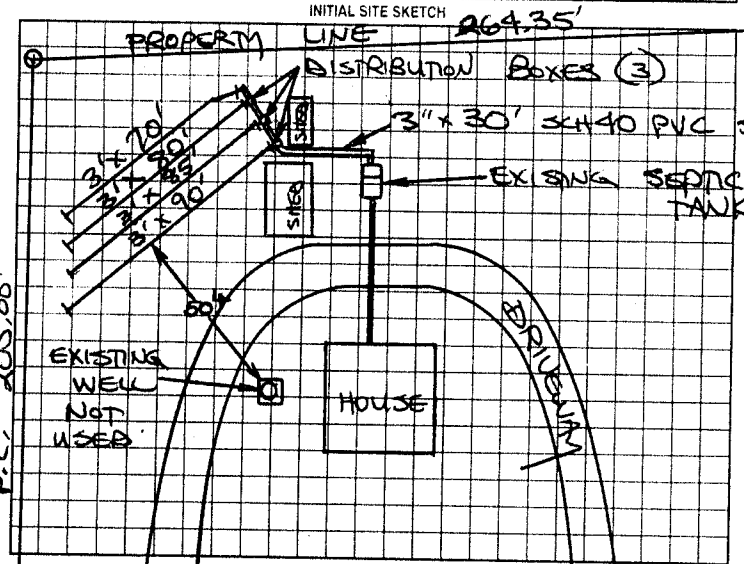

AS BUILT SKETCH

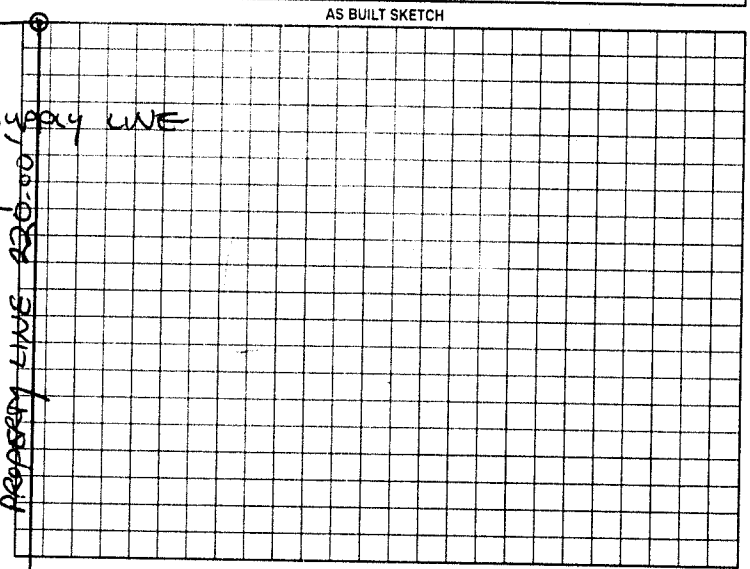

Permit can be suspended or revoked if any false information is supplied toward securing the permit/any unauthorized changes are made to the site/any unauthorized changes are made in the installation of the system. Improvement Permit with plat valid without expiration. Improvement Permit with site plan valid for sixty months. Authorization to Construct is valid for a period equal to that of Improvement Permit – not to exceed sixty months.

Signed: Melvin Mullins date Installed by: David Umbarger

Improvement Permit by: STEVE HEDRICK date 3-22-99 Operation Permit by: [illegible] date 4-12-99

Authorization to Construct by: STEVE HEDRICK date 3-22-99 Existing System Inspection by: date

LITTLE WILKESBORO ROAD (SR 1840)

HEALTH DEPT COPY (WHITE) CONTRACTOR COPY (FINAL) YELLOW OWNER COPY (INITIAL) PINK