IREDELL COUNTY HEALTH DEPARTMENT

STATESVILLE 704-878-5305 CI MOORESVILLE 704-664-5281

3367441924

IMPROVEMENT PERMIT / AUTHORIZATION TO CONSTRUCT / OPERATION PERMIT / EXISTING SYSTEM INSPECTION

PERMIT# 133176 PIN# 4871321495 DATE 12-28-05

OWNER OR CONTRACTOR Bilyeu Land Co PHONE: Business 704 876 4011 Home

ADDRESS 161 Tranquility Lane

LOCATION Hwy 21 N, L 3.5+ on Little Wilkesboro Rd. (R) on Rabbit Hwy, (L) on Tranquility Lane, Property on lft

SUBDIVISION Harmony Country Estates BLOCK / SECTION 2 LOT 21 LOT AREA .812 SITE CLASS. V PS DESIGN FLOW 360 L.T.A.R. .25

Septic Tank: 1000 Gallons; STB 760 Date 9-20-06
Pump Tank: ____ Gallons; PT ____ Date ____
Pump Make: ____ Model ____ Serial No. ____
Nitrification Field: No Fields 1 Square Feet 1440 Linear Feet 360
No Lines 5 Trench Width 3 Max Trench Bottom Depth 36" Gravel Depth n/a

☒ New System ☐ Repair System Type: I, II, III, IV, V, VI
System Description: 25% Reduction - Gravity
Repair System Description: 25% Reduction - Pump
Maintenance Agreement Required: ☐ Yes ☐ No


☒ House/Mod. Home No. Bedrooms 3
☐ Mobile Home No. Bathrooms ____
☐ Business No. Employees ____
☐ Other ____
☐ Slab ☒ Crawl Space ☐ Basement w/plumbing ☐ Basement wo/plumbing

Water Supply: ☐ Individual ☒ Public ☐ Community


Comments:/Conditions:

Comments:/Conditions:
Red Filter

INITIAL SITE SKETCH

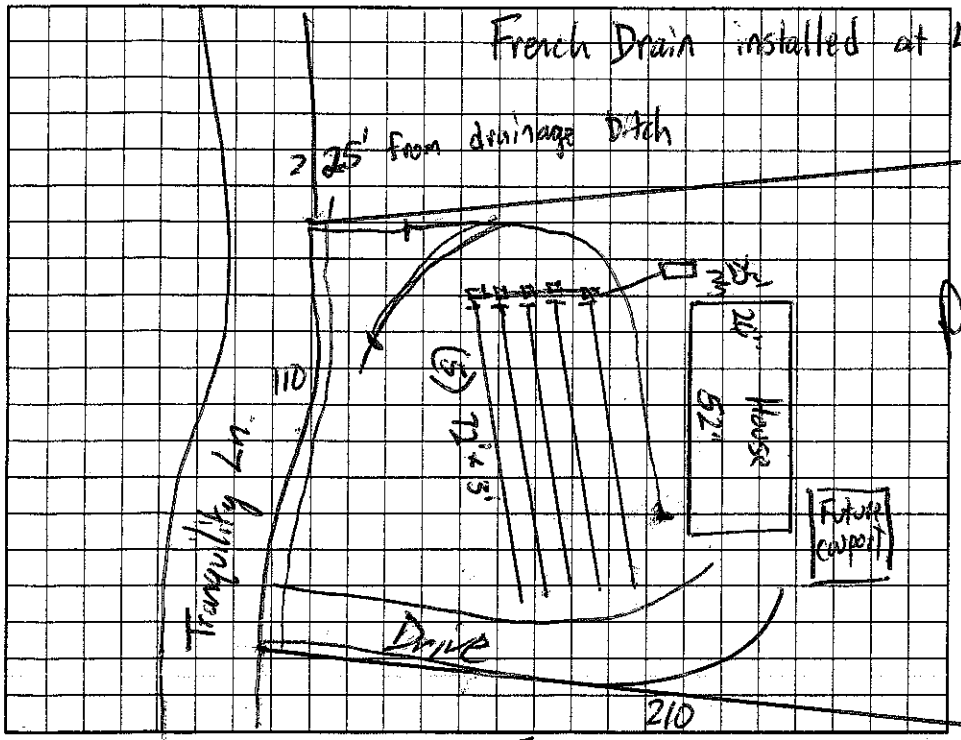

AS BUILT SKETCH

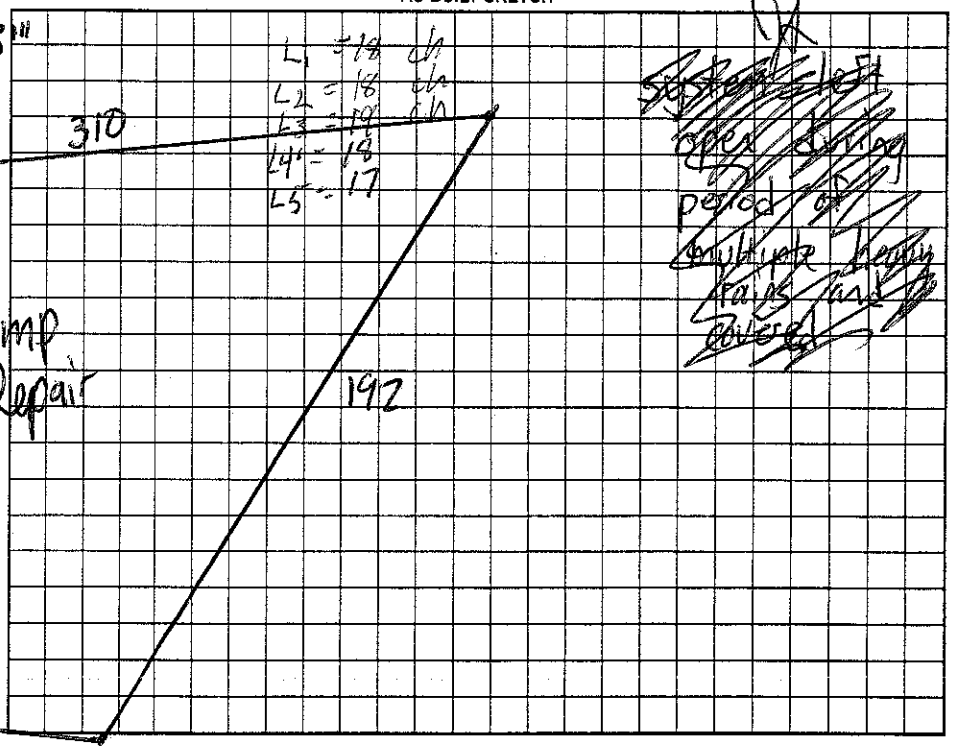

Permit can be suspended or revoked if any false information is supplied toward securing the permit/any unauthorized changes are made to the site/any unauthorized changes are made in the installation of the system. Improvement Permit with plat valid without expiration. Improvement Permit with site plan valid for sixty months. Authorization to Construct is valid for a period equal to that of Improvement Permit – not to exceed sixty months.

Signed: ____ date 12/28/05 Installed by: Brent Gallihes

Improvement Permit by: ____ date 12-28-05 Operation Permit by: ____ date 6-1-06

Authorization to Construct by: ____ date 12-28-05 Existing System Inspection by: ____ date ____

HEALTH DEPT. COPY: WHITE OWNER COPY (FINAL): YELLOW OWNER COPY (INITIAL): PINK