IREDELL COUNTY HEALTH DEPARTMENT

STATESVILLE 704-878-5305 MOORESVILLE 704-664-5281

IMPROVEMENT PERMIT / AUTHORIZATION TO CONSTRUCT / OPERATION PERMIT / EXISTING SYSTEM INSPECTION

PERMIT# [redacted]124293 PIN# 4871-32-3965 DATE 10/1/04

OWNER OR CONTRACTOR WAYNE HOMES MID-ATLANTIC, LLC PHONE: Business (704)872-8989 Home

ADDRESS 130 VICTORY LN. STATESVILLE NC 28625

LOCATION I-77N TR 901 TL LITTLE WILKESBORO TL RABBIT TL TRANQUILITY LOT ON RT AT END OF CUL-DE-SA

SUBDIVISION HARMONY ESTS BLOCK / SECTION III LOT 38 LOT AREA SITE CLASS. DESIGN FLOW L.T.A.R. 0.25 GPD/FT²

Septic Tank: 1000 Gallons; STB 1012 Date 7-25-04
Pump Tank: Gallons; PT Date
Pump Make: Model Serial No.
Nitrification Field: No Fields 1 Square Feet Linear Feet 480
No Lines 6 Trench Width 36" Max Trench Bottom Depth 24" Gravel Depth N/A

☑ New System ☐ Repair System Type: I, II, (III), IV, V, VI
System Description: GRAVITY 25% REDUCTION
Repair System Description: LP PANEL 50% RED
Maintenance Agreement Required: ☐ Yes ☑ No

☑ House/Mod. Home No. Bedrooms 4
☐ Mobile Home No. Bathrooms
☐ Business No. Employees
☐ Other

☐ Slab ☑ Crawl Space ☐ Basement w/plumbing ☐ Basement wo/plumbing


Water Supply: ☐ Individual ☑ Public ☐ Community IREDELL WATER

Comments:/Conditions: ① INSTALL 24" ON CONTOUR ② FRENCH DRAIN MUST BE INSTALLED 36-48" ③ MAINTAIN SETBACKS


Comments:/Conditions: ① SYSTEM ALTERED AS SHOWN, ② SEPTIC TANK WITH MARKER INSTALLED USING "TUFTITE" FILTER

SCALE 1"=50'

INITIAL SITE SKETCH

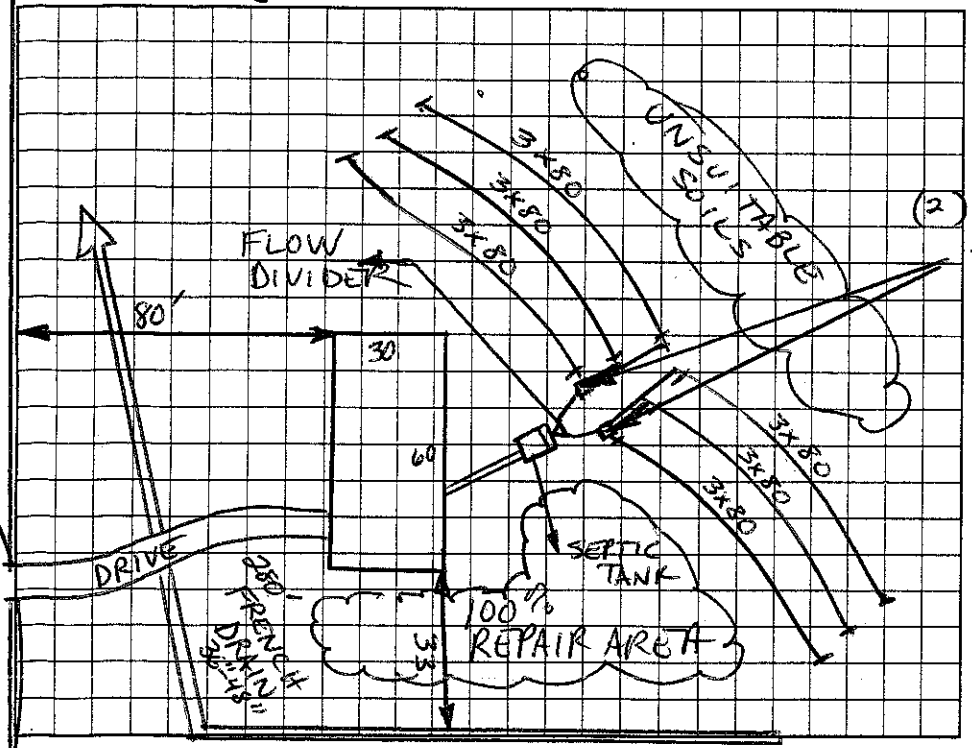

AS BUILT SKETCH

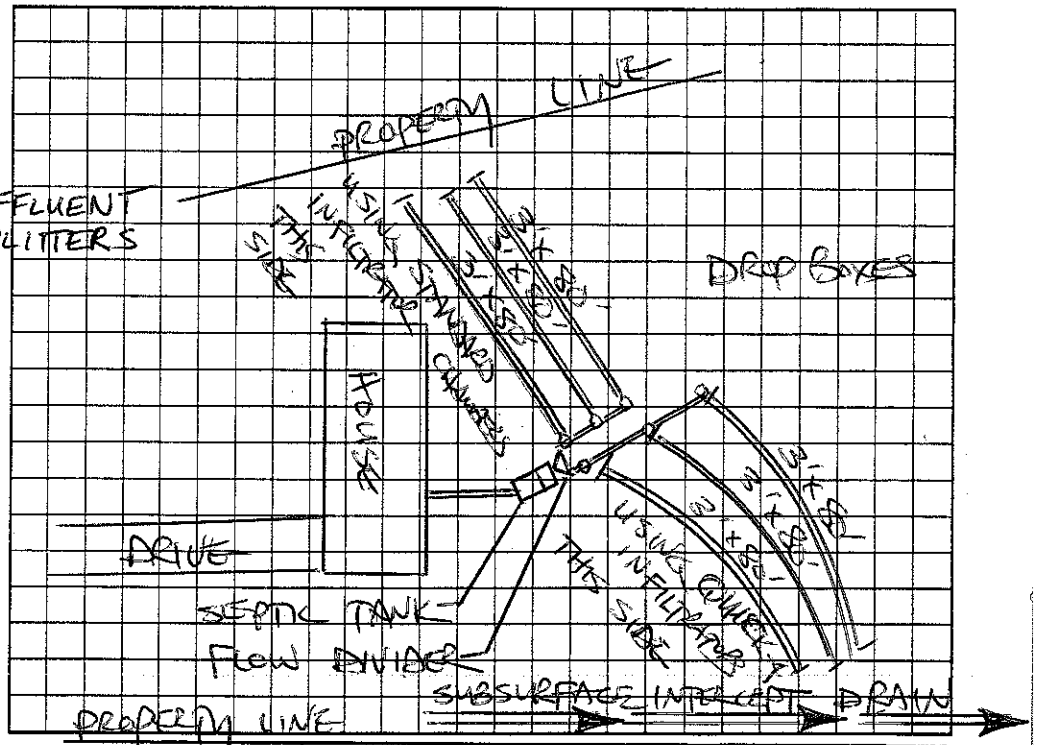

Permit can be suspended or revoked if any false information is supplied toward securing the permit/any unauthorized changes are made to the site/any unauthorized changes are made in the installation of the system. Improvement Permit with plat valid without expiration. Improvement Permit with site plan valid for sixty months. Authorization to Construct is valid for a period equal to that of Improvement Permit – not to exceed sixty months.

Signed: Scott Hyatt date 10-6-04

Improvement Permit by: Christopher M. Shue, LHS date 10-1-04

Authorization to Construct by: Christopher M. Shue, LHS date 10-1-04

Installed by: C & S GRADING

Operation Permit by: STEVE HENDRICK date 2-9-05

Existing System Inspection by: date

IMPROVEMENT PERMIT

HEALTH DEPT. COPY: WHITE OWNER COPY (FINAL): YELLOW OWNER COPY (INITIAL): PINK