IREDELL COUNTY HEALTH DEPARTMENT

STATESVILLE 704-878-5305 MOORESVILLE 704-664-5281

IMPROVEMENT PERMIT / AUTHORIZATION TO CONSTRUCT / OPERATION PERMIT / EXISTING SYSTEM INSPECTION

PERMIT# HARMONY/82115 PIN# DATE 6-17-99

OWNER OR CONTRACTOR BILLY RAY TRIVETTE PHONE: Business Home 546-2444

ADDRESS 356 SHEFFIELD ROAD, HARMONY NC 28634

LOCATION US 21 N, TL LITTLE WILKESBORO ROAD, 8TH LOT ON RIGHT PAST RABBIT HIGHWAY

SUBDIVISION HARMONY COUNTRY BLOCK / SECTION I LOT 3 LOT AREA 0.580 ACRE SITE CLASS PS DESIGN FLOW 360 L.T.A.R. 0.130 GPD/FT²

Septic Tank: 1000 Gallons; STB 1012 Date 2-23-00
Pump Tank: ____ Gallons; PT ____ Date ____
Pump Make: ____ Model ____ Serial No. ____
Nitrification Field: No Fields ⊥ Square Feet 1200 Linear Feet 400
No Lines FIVE Trench Width 36" Max Trench Bottom Depth 36

☑ New System ☐ Repair System Type: ☐ I ☑ II ☐ III ☐ IV ☐ V ☐ VI
System Description: CONVENTIONAL GRAVITY
Repair System Description: CONVENTIONAL GRAVITY
Maintenance Agreement Required: ☐ Yes ☑ No
Gravel Depth 12" ☐ Slab ☑ Crawl Space ☐ Basement w/plumbing ☐ Basement wo/plumbing


☑ House/Mod. Home No. Bedrooms 3
☐ Mobile Home No. Bathrooms 2
☐ Business No. Employees ____
☐ Other ____

Water Supply: ☐ Individual ☑ Public ☐ Community


Comments/Conditions:

Comments/Conditions: SEPTIC TANK RELOCATED DUE TO PLUMBING STUB-OUT W/O PRIOR H.D. APPROVAL @ SEPTIC TANK W/ RISERS INSTALLED USING "POLYLOK" FILTER

INITIAL SITE SKETCH SCALE: 1" = 40'

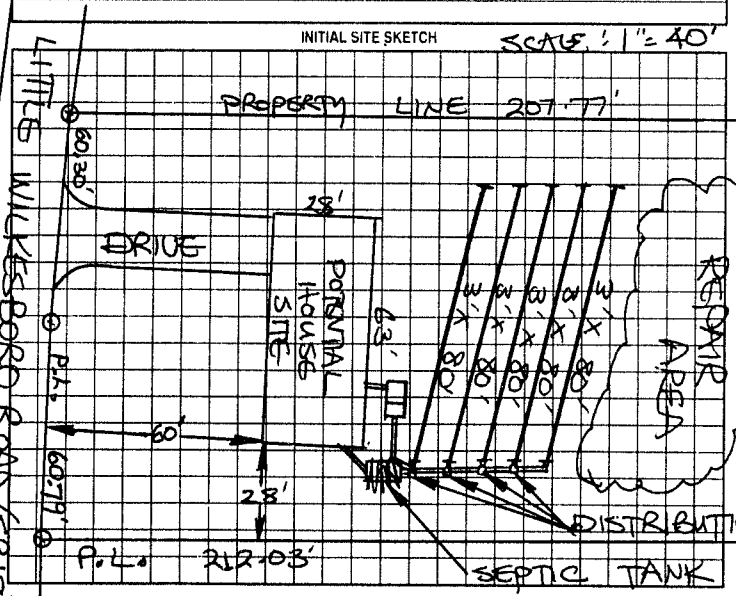

AS BUILT SKETCH

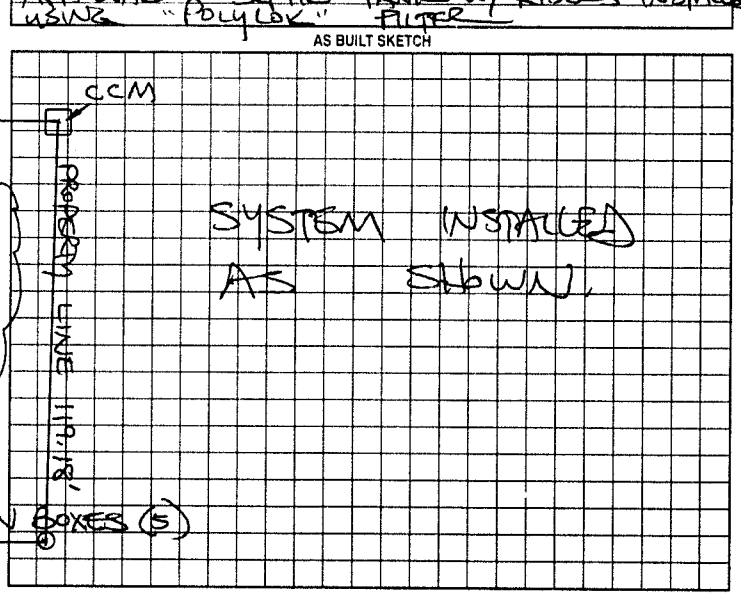

Permit can be suspended or revoked if any false information is supplied toward securing the permit/any unauthorized changes are made to the site/any unauthorized changes are made in the installation of the system. Improvement Permit with plat valid without expiration. Improvement Permit with site plan valid for sixty months. Authorization to Construct is valid for a period equal to that of Improvement Permit – not to exceed sixty months.

Signed: ____ date 6-17-99 Installed by: STEVE JORDAN

Improvement Permit by: STEVE HEDRICK date 6-17-99 Operation Permit by: STEVE HEDRICK date 5-19-00

Authorization to Construct by: STEVE HEDRICK date 6-17-99 Existing System Inspection by: ____ date ____

HEALTH DEPT. COPY: WHITE OWNER COPY (FINAL): YELLOW OWNER COPY (INITIAL): PINK