# IREDELL COUNTY HEALTH DEPARTMENT

STATESVILLE 704-878-5305 MOORESVILLE 704-664-5281

## IMPROVEMENT PERMIT / AUTHORIZATION TO CONSTRUCT / OPERATION PERMIT / EXISTING SYSTEM INSPECTION

PERMIT# HARMONY 01363 PIN#

OWNER OR CONTRACTOR HUNTING CREEK BUILDING CO, INC PHONE: Business 539-5539 Home DATE 5-9-98

ADDRESS 1000 UNION GROVE ROAD IR, NC 28689

LOCATION US 31 N TL LITTLE WILKESBORO ROAD, 6TH LOT ON RIGHT PAST RABBIT HIGHWAY

SUBDIVISION HARMONY COUNTRY ES BLOCK / SECTION I LOT 5 LOT AREA 0.580 SITE CLASS. PS DESIGN FLOW 360 L.T.A.R. 0.30 GPD/FT²

Septic Tank: 1000 Gallons; STB 1012 Date 4-3-98

Pump Tank: ____ Gallons; PT ____ Date ____

Pump Make: ____ Model ____ Serial No. ____

Nitrification Field: No Fields 1 Square Feet 1200 Linear Feet 400

No Lines FIVE Trench Width 36" Max Trench Bottom Depth 36" Gravel Depth 12"

☑ New System ☐ Repair System Type: I ☑ II, III, IV, V, VI

System Description: CONVENTIONAL SERIAL

Repair System Description: CHAMBERED, PUMP/GRAV

Maintenance Agreement Required: ☐ Yes ☑ No

☑ House/Mod. Home No. Bedrooms 3

☐ Mobile Home No. Bathrooms 2

☐ Business No. Employees ____

☐ Other ____


☐ Slab ☑ Crawl Space ☐ Basement w/plumbing ☐ Basement wo/plumbing

Water Supply: ☐ Individual ☑ Public ☐ Community


Comments:/Conditions: RAKE TRENCH SIDEWALLS WHERE SMEARING OCCURS & APPLY A LIGHT DUSTING OF LIME PRIOR TO INSTALLATION OF STONE.

Comments:/Conditions:

INITIAL SITE SKETCH SCALE: 1" = 40'

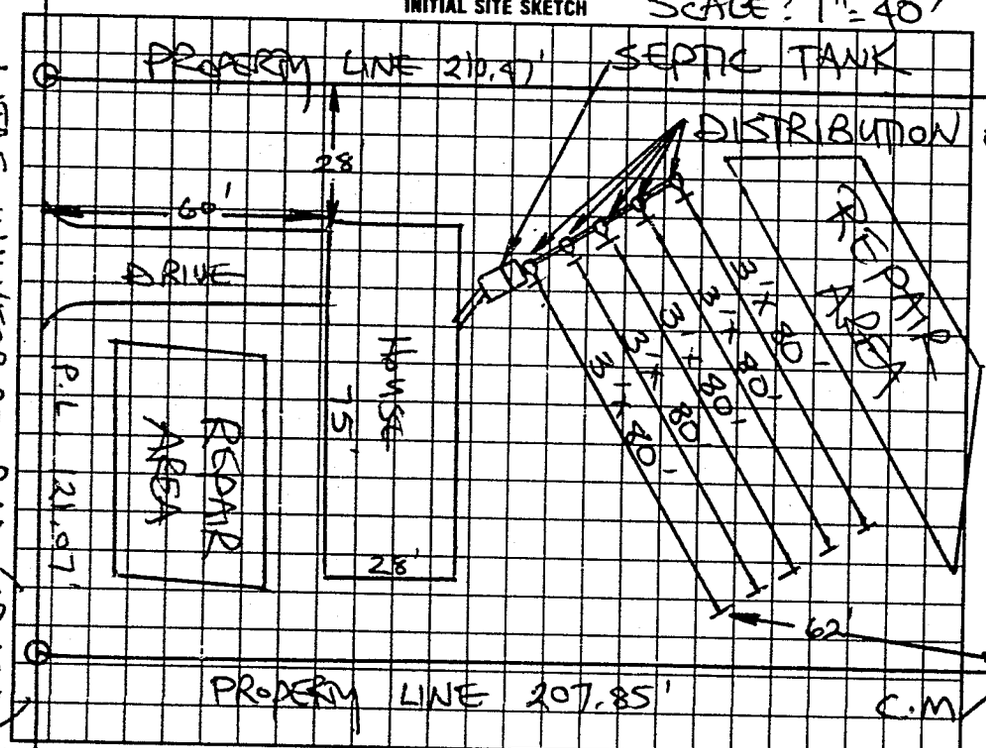


AS BUILT SKETCH

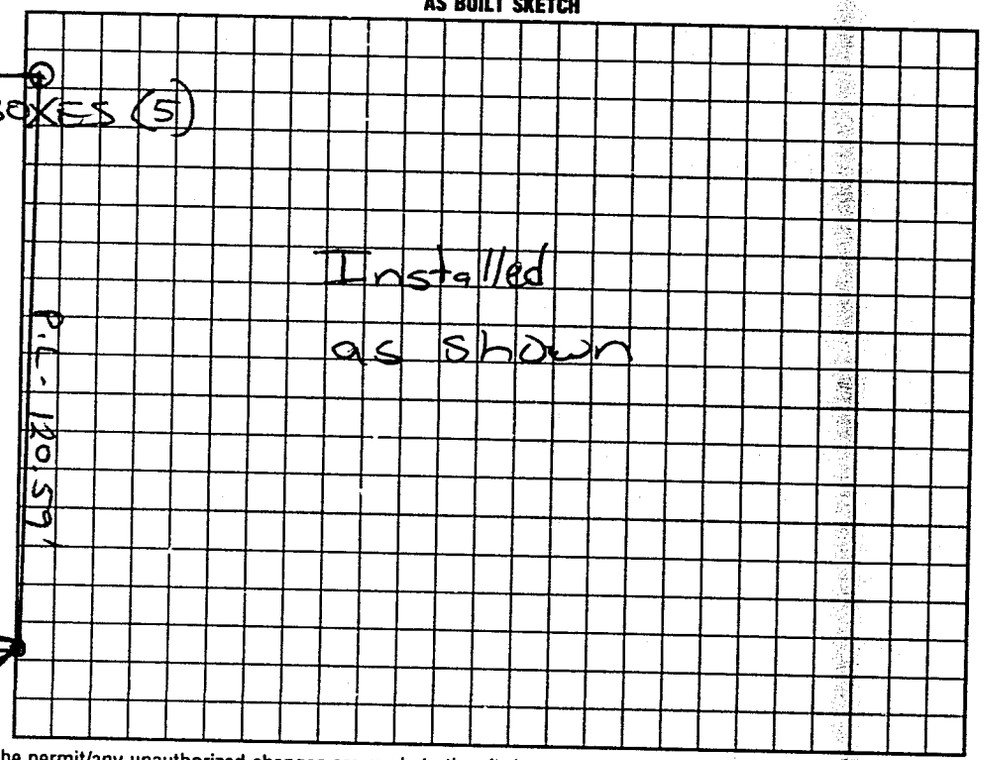


I understand that this permit can be suspended or revoked if any false information is supplied toward securing the permit/any unauthorized changes are made to the site/any unauthorized changes are made in the installation of the system. Improvement Permit with plat valid without expiration. Improvement Permit with site plan valid for sixty months. Authorization to Construct is valid for a period equal to that of Improvement Permit – not to exceed sixty months.

Signed: Jennifer Winkler date 5-13-98

Improvement Permit by: STEVE HEDRICK date 5-9-98

Authorization to Construct by: STEVE HEDRICK date 5-9-98

Installed by: Tommy Frye

Operation Permit by: Mark C Outlaw date 6-11-98

Existing System Inspection by: ____ date ____

HEALTH DEPT. COPY. WHITE INSPECTION COPY (FINAL) GREEN OWNER COPY (FINAL) YELLOW INSPECTION COPY (INITIAL) PINK OWNER COPY (INITIAL) GOLD