93428

IREDELL COUNTY HEALTH DEPARTMENT

STATESVILLE 704-878-5305 MOORESVILLE 704-664-5281

IMPROVEMENT PERMIT / AUTHORIZATION TO CONSTRUCT / OPERATION PERMIT / EXISTING SYSTEM INSPECTION

PERMIT# HARMONY PIN# 4871 32 7119 DATE 11-1-00

OWNER OR CONTRACTOR WILLIAM MUNDY PHONE: Business (336) 492-7634 Home

ADDRESS P.O. BOX 791, MOCKSVILLE, NC 27028

LOCATION US 21 N, TL LITTLE WILKESBORO, TR RABBIT HWY, TL TRANQUILITY LANE, 7TH LOT ON LEFT

SUBDIVISION HARMONY COUNTRY BLOCK / SECTION LOT 16 LOT AREA 0.516 ACRE SITE CLASS PS DESIGN FLOW 360 L.T.A.R. 0.30 GAD/FT²

Septic Tank: 1000 Gallons: STB 864 Date 6-30-01
Pump Tank: Gallons: PT Date
Pump Make: Model Serial No.
Nitrification Field: No Fields 1 Square Feet 840 to 1200 Linear Feet 200+
No Lines SIX Trench Width 24" Max Trench Bottom Depth 36" Gravel Depth SAND 6"

☑ New System ☐ Repair System Type: ☐ I, II, III, IV, V, VI
System Description: [redacted] 50% REDUCTION
Repair System Description: CONVENTIONAL, PUMP
Maintenance Agreement Required: ☐ Yes ☑ No

☑ House/Mod. Home No. Bedrooms 3
☐ Mobile Home No. Bathrooms 2
☐ Business No. Employees
☐ Other


☐ Slab ☑ Crawl Space ☐ Basement w/plumbing ☐ Basement wo/plumbing

Water Supply: ☐ Individual ☑ Public ☐ Community

Comments/Conditions: ① INSTALL 50% REDUCTION SYSTEM USING 460 PPBPS PANELS IN SIX LINES AS SHOWN ② USE ONE FLOW DIVIDER TEE TO ACHIEVE EQUAL DISTRIBUTION INTO TWO DIST. BOXES FEEDING 23 PPBPS PANELS EACH.

Comments/Conditions: ③ KEEP SYSTEM MINIMUM 10 FEET FROM WATER LINE, 15 FEET FROM TOP OF EMBANKMENT

INITIAL SITE SKETCH

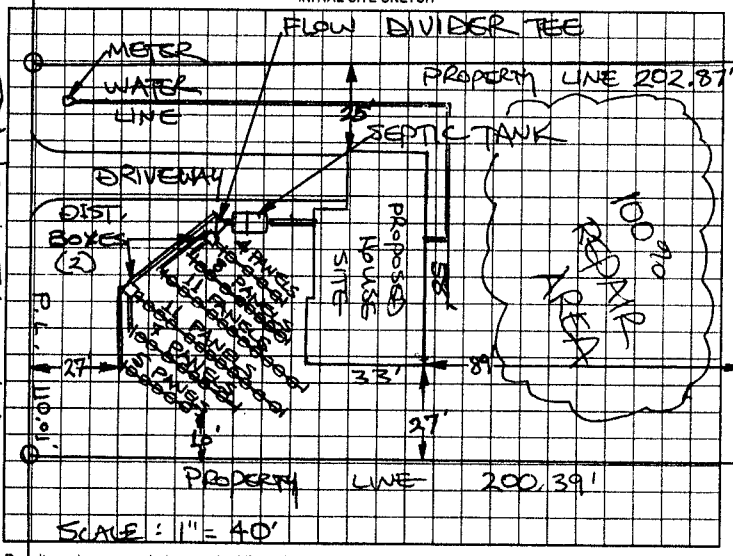

TRANQUILITY LANE

AS BUILT SKETCH

SEPTIC TANK WITH RISERS INSTALLED USING "ZABEL" FILTER

SYSTEM INSTALLED ACCORDING TO INITIAL SITE SKETCH

Permit can be suspended or revoked if any false information is supplied toward securing the permit/any unauthorized changes are made to the site/any unauthorized changes are made in the installation of the system. Improvement Permit with plat valid without expiration. Improvement Permit with site plan valid for sixty months. Authorization to Construct is valid for a period equal to that of Improvement Permit – not to exceed sixty months.

Signed: Cheryl S. Mundy date 11-2-00 Installed by: TOMMY NIXON

Improvement Permit by: STEVE HEDRICK date 11-1-00 Operation Permit by: STEVE HEDRICK date 9-7-01

Authorization to Construct by: STEVE HEDRICK date 11-1-00 Existing System Inspection by: date

HEALTH DEPT. COPY WHITE OWNER COPY (FINAL) YELLOW OWNER COPY (INITIAL) PINK