82254

IREDELL COUNTY HEALTH DEPARTMENT

STATESVILLE 704-878-5305 MOORESVILLE 704-664-5281

IMPROVEMENT PERMIT / AUTHORIZATION TO CONSTRUCT / OPERATION PERMIT / EXISTING SYSTEM INSPECTION

PERMIT# HARMONY PIN# DATE 6-22-99

OWNER OR CONTRACTOR GENE PICKENS PHONE: Business Home 878-9837

ADDRESS 111 WOODVIEW DRIVE STATESVILLE NC 28625

LOCATION US 21 N, TL LITTLE WILKESBORO RD, TR RABBIT HWY, TL TRANQUILITY LANE, 6TH LOT ON LEFT

SUBDIVISION HARMONY COUNTRY BLOCK / SECTION LOT 15 LOT AREA 0.524 ACRE SITE CLASS PS DESIGN FLOW 360 L.T.A.R. 0.30 GPD/FT2

Septic Tank: 1000 Gallons; STB 1012 Date 10-29-99
Pump Tank: Gallons; PT Date
Pump Make: Model Serial No.
Nitrification Field: No Fields 1 Square Feet 60 TO 1200 Linear Feet 300
No Lines SIX Trench Width 36" Max Trench Bottom Depth 30"

✓ New System ☐ Repair System Type: I II III IV V VI
System Description: 25% REDUCTION SYSTEM
Repair System Description: 25% REDUCTION PUMP
Maintenance Agreement Required: ☐ Yes ✓ No
Gravel Depth SAND 6" ☐ Slab ✓ Crawl Space ☐ Basement w/plumbing ☐ Basement wo/plumbing


✓ House/Mod. Home No. Bedrooms 3
☐ Mobile Home No. Bathrooms 2
☐ Business No. Employees
☐ Other

Water Supply: ☐ Individual ✓ Public ☐ Community


Comments/Conditions: INSTALL 25% REDUCTION SYSTEM USING 48 CHAMBERS OR 30 HB'S SECTIONS

Comments/Conditions: SEPTIC TANK W/ RISERS INSTALLED USING "POLYLOK" FILTERS

INITIAL SITE SKETCH

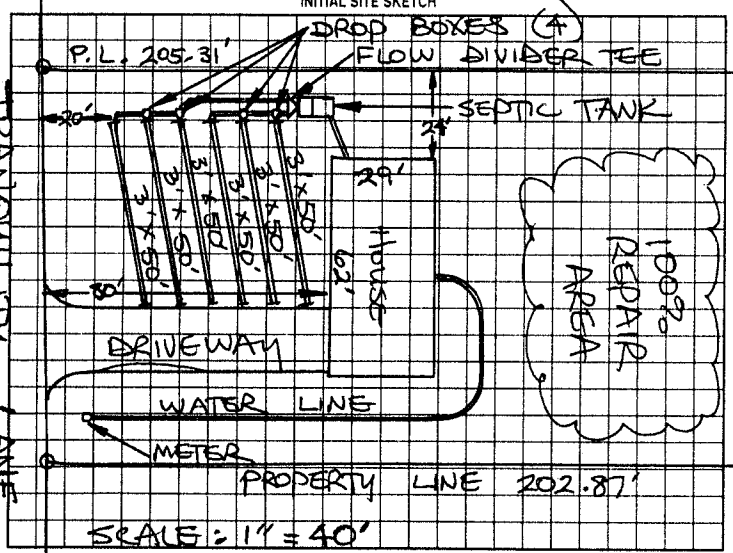

AS BUILT SKETCH

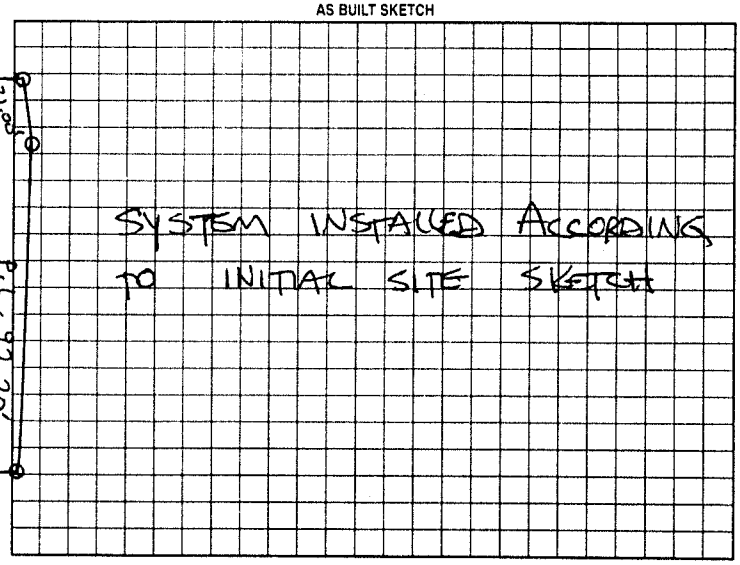

Permit can be suspended or revoked if any false information is supplied toward securing the permit/any unauthorized changes are made to the site/any unauthorized changes are made in the installation of the system. Improvement Permit with plat valid without expiration. Improvement Permit with site plan valid for sixty months. Authorization to Construct is valid for a period equal to that of Improvement Permit - not to exceed sixty months.

Signed: + Gene Pickens date 6-22-99 Installed by: WES LYTTON

Improvement Permit by: STEVE HEDRICK date 6-22-99 Operation Permit by: STEVE HEDRICK date 12-30-99

Authorization to Construct by: STEVE HEDRICK date 6-22-99 Existing System Inspection by: date

HEALTH DEPT COPY: WHITE OWNER COPY (FINAL) YELLOW OWNER COPY (INITIAL) PINK