THIS PERMIT REPLACES ONE ISSUED 3-17-09

IREDELL COUNTY HEALTH DEPARTMENT

STATESVILLE 704-878-5305 (ad) MOORESVILLE 704-664-5281

IMPROVEMENT PERMIT / AUTHORIZATION TO CONSTRUCT / OPERATION PERMIT / EXISTING SYSTEM INSPECTION

PERMIT # 154869 PIN # 4871328602 DATE 4-3-09

OWNER or APPLICANT Clayton Homes / Patsy Combs PHONE: Business 704 873 2547 Home: 704 876 0600

OWNER or APPLICANT ADDRESS (a) 138 Tranquility Line

LOCATION / DIRECTIONS Hwy 21N (L) on Little Wilkesboro (R) on Rabbit Hwy (L) on Tranquility, lot on (R)

SUBDIVISION Harmony Country Estates BLOCK / SECTION 2 LOT # 128 LOT AREA 1.157 DESIGN FLOW 3 L.T.A.R. .25

Septic Tank 1000 Gallons: STB 760 Date 11-15-08

Pump Tank Gallons: P T Date

Pump Make Model Serial #

Nitrification Field No Fields 1 No Lines (5) Linear Feet 360

Trench Width 36" Max. Trench Bottom Depth 30" Gravel Depth n/a

☒ New System ☐ Repair ☐ Expansion System Type: I (II) III IV V VI

System Description: 25% Reduction Gravity

Repair System Description: 25% Reduction Gravity

Maintenance Agreement Required ☐ YES ☒ NO

☒ GRAVITY ☐ PRESSURE


☒ Residence No. Bedrooms 3 ☐ Business No. Persons ☐ Other No. Employees ☐ Slab ☒ Crawl Space ☐ Basement w/plumbing ☐ Basement w/o plumbing

Water Supply: ☐ Private ☒ Public ☐ Community


Comments / Conditions

Comments / Conditions Black / Red Filter

INITIAL SITE SKETCH

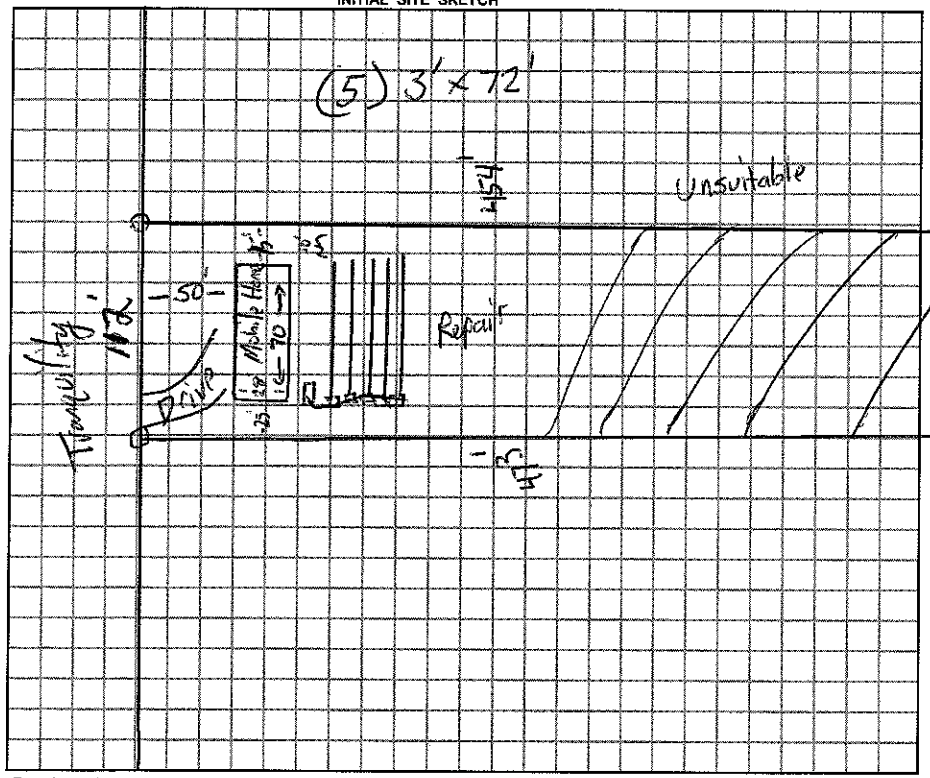

AS BUILT SKETCH

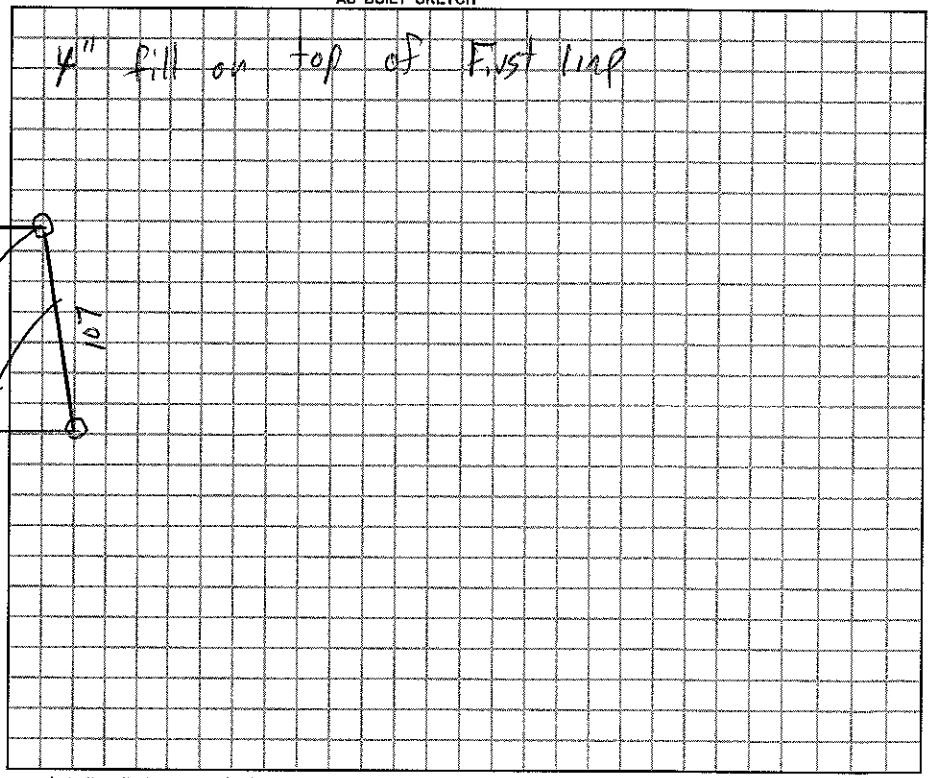

Permit can be suspended or revoked if any false information is supplied toward securing the permit / any unauthorized changes are made to the site / any unauthorized changes are made in the installation of the system.

☐ *IMPROVEMENT PERMIT w / plat valid without expiration.* ☒ *IMPROVEMENT PERMIT w / site plan valid for 60 mos.* ☒ *AUTHORIZATION TO CONSTRUCT valid for period equal to IMPROVEMENT PERMIT-not to exceed 60 mo.*

Owner / Applicant Signature: Date 4-6-09

Improvement Permit by: Date 4-3-09

Authorzation to Construct by: Date 4-3-09

YOU SHOULD CONTACT A LOCATOR SERVICE PRIOR TO ANY EXCAVATION.

Installed by: Abco Grading

Operation Permit by: Date: 6-1-09

Existing System Inspected by: Date:

WHITE COPY Environmental Health YELLOW COPY (Final) Owner / Applicant PINK COPY (Initial) Owner / Applicant