IREDELL COUNTY HEALTH DEPARTMENT

STATESVILLE 704-878-5305 87254 MOORESVILLE 704-664-5281

IMPROVEMENT PERMIT / AUTHORIZATION TO CONSTRUCT / OPERATION PERMIT / EXISTING SYSTEM INSPECTION

PERMIT# HARMONY 87048 PIN# DATE 12-17-99

OWNER OR CONTRACTOR GENE PICKENS PHONE: Business Home 878-9837

ADDRESS 111 WOODVIEW DRIVE, STATESVILLE NC 28625

LOCATION US 21 NORTH, TL LITTLE WILKESBORO RD, TR RABBIT AWY, TL TRANQUILITY LANE, LOT 14 ON LEFT

SUBDIVISION HARMONY COUNTRY BLOCK / SECTION LOT 14 LOT AREA 0.524 ACRE SITE CLASS PS DESIGN FLOW 360 L.T.A.R. 0.30 GPD/FT²

Septic Tank: 1000 Gallons; STB 794 Date 4-23-00
Pump Tank: Gallons; PT Date
Pump Make: Model Serial No.
Nitrification Field: No Fields 1 Square Feet 1200 Linear Feet 400
No Lines EIGHT Trench Width 36" Max Trench Bottom Depth 36" Gravel Depth 12"

☒ New System ☐ Repair System Type: I (II) III IV V VI
System Description: CONVENTIONAL GRAVITY
Repair System Description: CONVENTIONAL PUMP
Maintenance Agreement Required: ☐ Yes ☒ No
☐ Slab ☒ Crawl Space ☐ Basement w/plumbing ☐ Basement wo/plumbing


☒ House/Mod. Home No. Bedrooms 3
☐ Mobile Home No. Bathrooms 2
☐ Business No. Employees
☐ Other

Water Supply: ☐ Individual ☒ Public ☐ Community

Comments/Conditions: INSTALL ONE FLOW DIVIDER TEE TO ACHIEVE EQUAL DISTRIBUTION INTO TWO SETS OF FOUR LINES EACH

Comments/Conditions: SEPTIC TANK W/RISERS INSTALLED USING "ZABEL" FILTER

SCALE: 1"=40' INITIAL SITE SKETCH

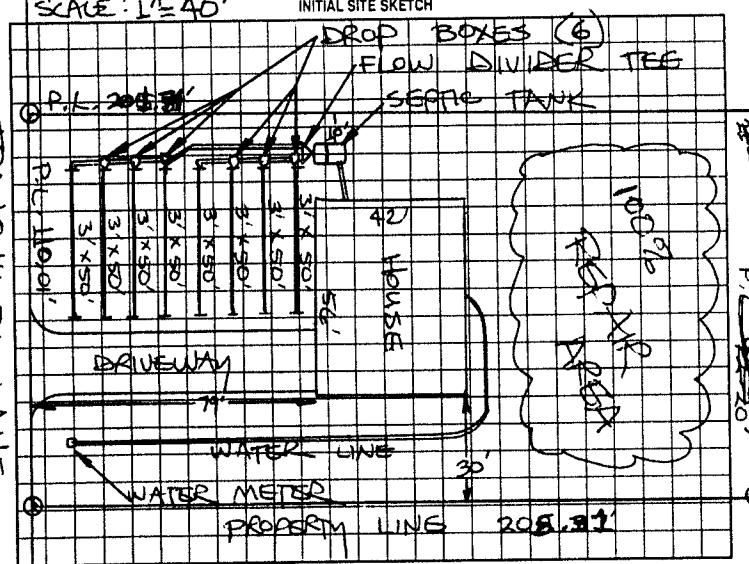

AS BUILT SKETCH

SYSTEM INSTALLED ACCORDING TO INITIAL SITE SKETCH

Permit can be suspended or revoked if any false information is supplied toward securing the permit/any unauthorized changes are made to the site/any unauthorized changes are made in the installation of the system. Improvement Permit with plat valid without expiration, Improvement Permit with site plan valid for sixty months. Authorization to Construct is valid for a period equal to that of Improvement Permit – not to exceed sixty months.

Signed: Gene Pickens date 12-17-99

Improvement Permit by: STEVE HEDRICK date 12-17-99

Authorization to Construct by: STEVE HEDRICK date 12-17-99

Installed by: WEB LYTTON

Operation Permit by: STEVE HEDRICK date 8-10-00

Existing System Inspection by: date

HEALTH DEPT. COPY WHITE OWNER COPY (FINAL) YELLOW OWNER COPY (INITIAL) PINK