IREDELL COUNTY HEALTH DEPARTMENT

STATESVILLE 704-878-5305 MOORESVILLE 704-664-5281

IMPROVEMENT PERMIT / AUTHORIZATION TO CONSTRUCT / OPERATION PERMIT / EXISTING SYSTEM INSPECTION

PERMIT# 140424 PIN# 4871329611 DATE 2-22-07

OWNER OR APPLICANT ERA Wilder Realty PHONE: Business 704 873 4570 Home

ADDRESS 132 Tranquility Lane

LOCATION Little Wilkesboro Rd, left on Rabbit, left on Tranquility, prop on (R)

SUBDIVISION Harmony County Estates BLOCK / SECTION II LOT 29 LOT AREA 1.2 SITE CLASS PS DESIGN FLOW 360 L.T.A.R. .2

Septic Tank: 1000 Gallons; STB 760 Date 2-22-7

Pump Tank: Gallons; PT Date

Pump Make: Model Serial No.

Nitrification Field: No Fields 1 Square Feet 1800 Linear Feet 450

No Lines 5 Trench Width 36" Max Trench Bottom Depth 24" Gravel Depth n/a

☒ New System ☐ Repair ☐ Expansion System Type: I (II) III IV V VI

System Description: 25% Reduction

Repair System Description: 25% Reductio

Maintenance Agreement Required: ☐ Yes ☒ No

☒ House (Mod) Home ☐ Mobile Home ☐ Business ☐ Other

No. Bedrooms No. Persons No. Employees

Water Supply: ☐ Individual ☒ Public ☐ Community


☐ Slab ☒ Crawl Space ☐ Basement w/plumbing ☐ Basement wo/plumbing

Comments:/Conditions:


Comments:/Conditions:

RF

INITIAL SITE SKETCH

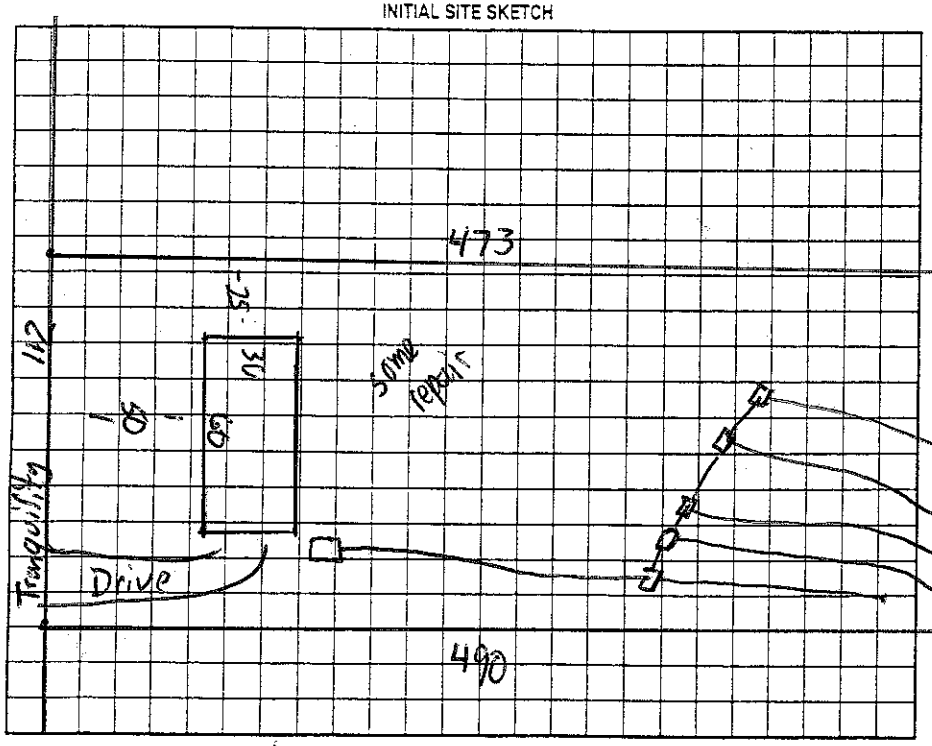

AS BUILT SKETCH

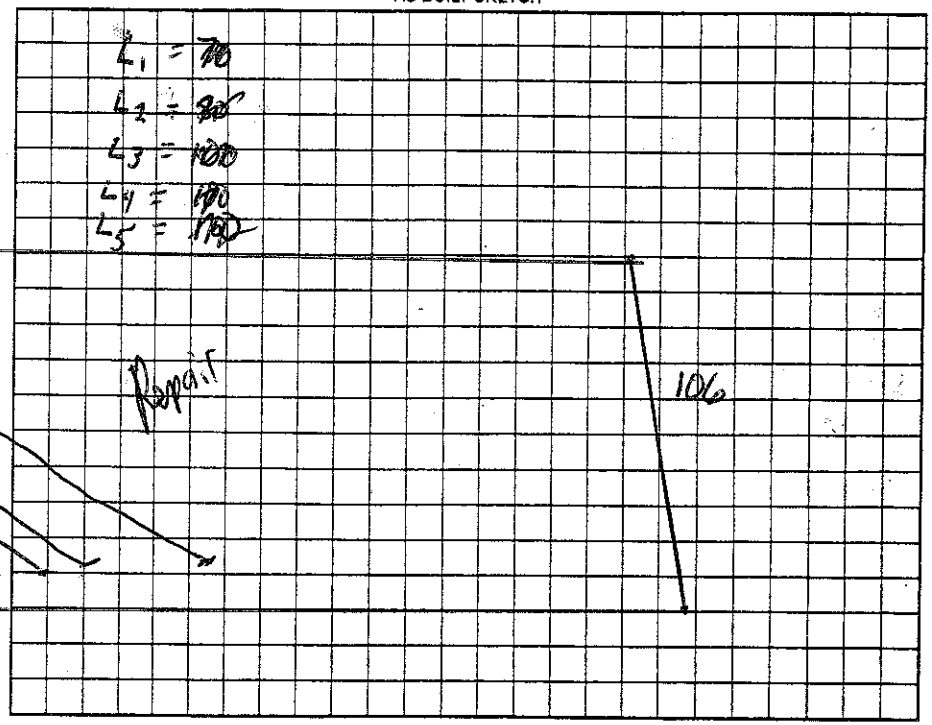

Permit can be suspended or revoked if any false information is supplied toward securing the permit/any unauthorized changes are made to the site/any unauthorized changes are made in the installation of the system. Improvement Permit with plat valid without expiration ☐ Improvement Permit with site plan valid for sixty months ☐ Authorization to Construct is valid for a period equal to that of Improvement Permit – not to exceed sixty months.

Signed: date 2/22/07 Installed by: Abee Grading

Improvement Permit by: date Operation Permit by: date 6-18-07

Authorization to Construct by: date Existing System Inspection by: date

HEALTH DEPT. COPY: WHITE OWNER COPY (FINAL): YELLOW OWNER COPY (INITIAL): PINK