IREDELL COUNTY HEALTH DEPARTMENT - *ENVIRONMENTAL HEALTH* ☐ STATESVILLE OFFICE 704-878-5305 ☐ MOORESVILLE OFFICE 704-664-5281

IMPROVEMENT PERMIT / AUTHORIZATION TO CONSTRUCT / OPERATION PERMIT / EXISTING SYSTEM INSPECTION

PERMIT # 168029 PIN # 4871-38-8134 DATE 23 August 2011

OWNER Brian & Sandra Wallace APPLICANT: American Home Place PHONE: Home/Cell # (828) 779-2303 Business #

SITE ADDRESS 404 Rabbit Hwy Harmony OWNER / APPLICANT ADDRESS

SITE DIRECTIONS Hwy 21 N TL Little Fiddlebone - TR Rabbit Hwy 1 mile to on Rt.

SUBDIVISION BLOCK / SECTION LOT # LOT AREA 5.3ac. DESIGN FLOW 600 g/d L.T.A.R. 0.3 g/ft²/d

Septic Tank 1500 Gallons: STB ~~1000~~ 528 Date 11-19-08
Pump Tank Gallons: P T Date
Pump Make Model Serial #
No. Nitrification Fields: 1 No. Lines 4 Linear Feet 500
Trench Width 36" Max. Trench Bottom Depth 36" Gravel Depth N/A


☑ New System ☐ Repair ☐ Expansion System Type I II (III) IV V VI
System Description: 25% Reduction
Repair System Description: 25% Reduction
Maintenance Agreement Required ☐ YES ☒ NO
☒ GRAVITY ☐ PRESSURE

☑ Residence No. Bedrooms 5
☐ Business No. Persons
☐ Other No. Employees
☐ Slab ☑ Crawl Space
☐ Basement w/plumbing ☐ Basement w/o plumbing

Water Supply
☑ Private
☐ Public
☐ Community

Comments / Conditions Follow contour / Keep 100' from well / Red Flag

INITIAL SITE SKETCH

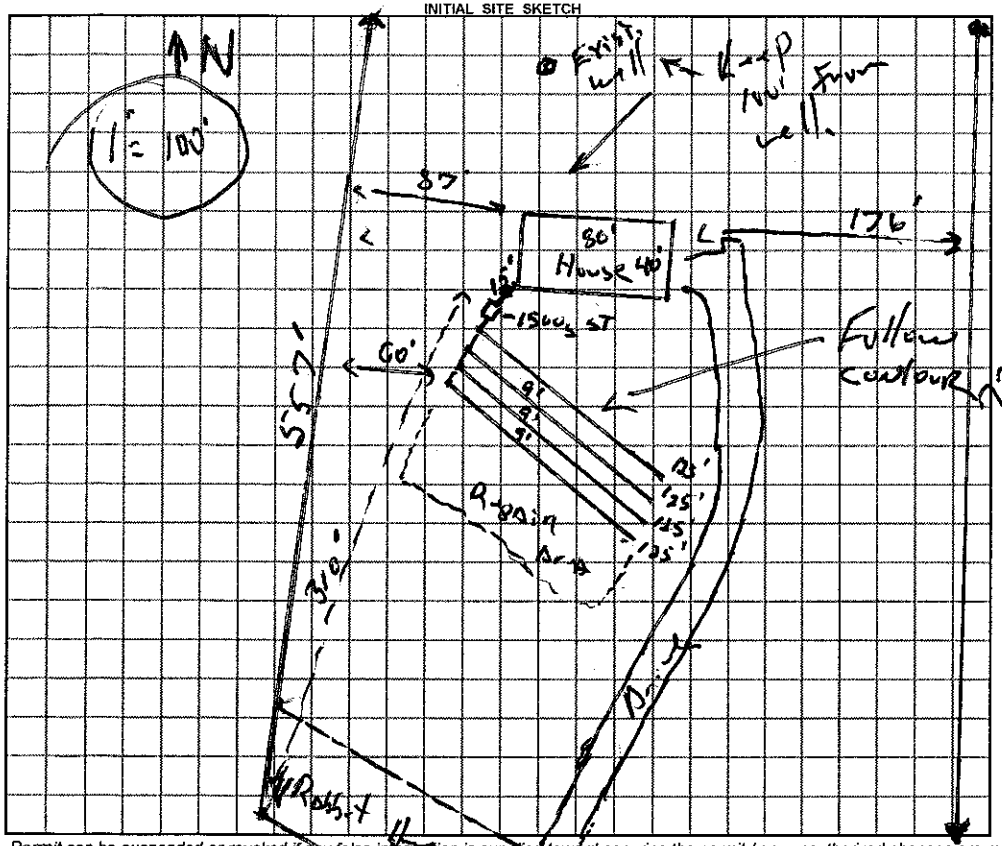

AS BUILT SKETCH

Permit can be suspended or revoked if any false information is supplied toward securing the permit / any unauthorized changes are made to the site / any unauthorized changes are made in the installation of the system.

☐ *IMPROVEMENT PERMIT* with plat valid without expiration. ☑ *IMPROVEMENT PERMIT* with plat valid without expiration. ~~site plan valid 60 mo.~~ ☑ *AUTHORIZATION TO CONSTRUCT* valid for period equal to IMPROVEMENT PERMIT--not to exceed 60 mo.

Owner / Applicant Signature: Date 8-23-11 Installed by: Tommy Frye

IMPROVEMENT PERMIT by: REHS Date 23 Aug. 11 OPERATION PERMIT by: REHS Date 10-25-11

AUTHORIZATION TO CONSTRUCT by: REHS Date 23 Aug. 11 Existing System Inspected by: REHS Date

YOU SHOULD CONTACT A LOCATOR SERVICE PRIOR TO ANY EXCAVATION

White Copy – Environmental Health YELLOW COPY (Final) Owner / Applicant PINK COPY (Initial) Owner / Applicant