IREDELL COUNTY HEALTH DEPARTMENT

STATESVILLE 704-878-5305 MOORESVILLE 704-664-5281

IMPROVEMENT PERMIT / AUTHORIZATION TO CONSTRUCT / OPERATION PERMIT / EXISTING SYSTEM INSPECTION

PERMIT# 146426 PIN# 4871406396 DATE 8-13-08

OWNER OR APPLICANT Harmony Baptist Church PHONE: Business _____ Home 704 546 2279

ADDRESS 135 Little Wilkesboro Rd Harmony

LOCATION Hwy 21 N. left on Little Wilkesboro Rd - Church on left

SUBDIVISION n/a BLOCK / SECTION _____ LOT _____ LOT AREA 16.151 SITE CLASS. PS DESIGN FLOW 720 L.T.A.R. .3

Septic Tank: 1350 Gallons; STB 336-1500 Date 1-14-09

Pump Tank: _____ Gallons; PT GT-1000 Date 4-209

Pump Make: _____ Model _____ Serial No. _____

Nitrification Field: No Fields ___ Square Feet 2400 Linear Feet 600

No Lines 7 Trench Width 36" Max Trench Bottom Depth 36"

☑ New System ☐ Repair ☐ Expansion System Type: I II III IV V VI

System Description: 25% Reduction Gravity

Repair System Description: 25% Reduction - Pump

Maintenance Agreement Required: ☐ Yes ☑ No

Gravel Depth n/a ☐ Gravity ☐ Pressure ☑ Slab ☐ Crawl Space ☐ Basement w/plumbing ☐ Basement wo/plumbing

☐ House/Mod. Home No. Bedrooms ___

☐ Mobile Home No. Persons ___

☐ Business No. Employees ___

☑ Other Fellowship Hall

Water Supply: ☐ Individual ☑ Public ☐ Community

Comments:/Conditions:

900 gallon grease trap required


Kitchen will be used as a warming station

Comments:/Conditions:

INITIAL SITE SKETCH



AS BUILT SKETCH

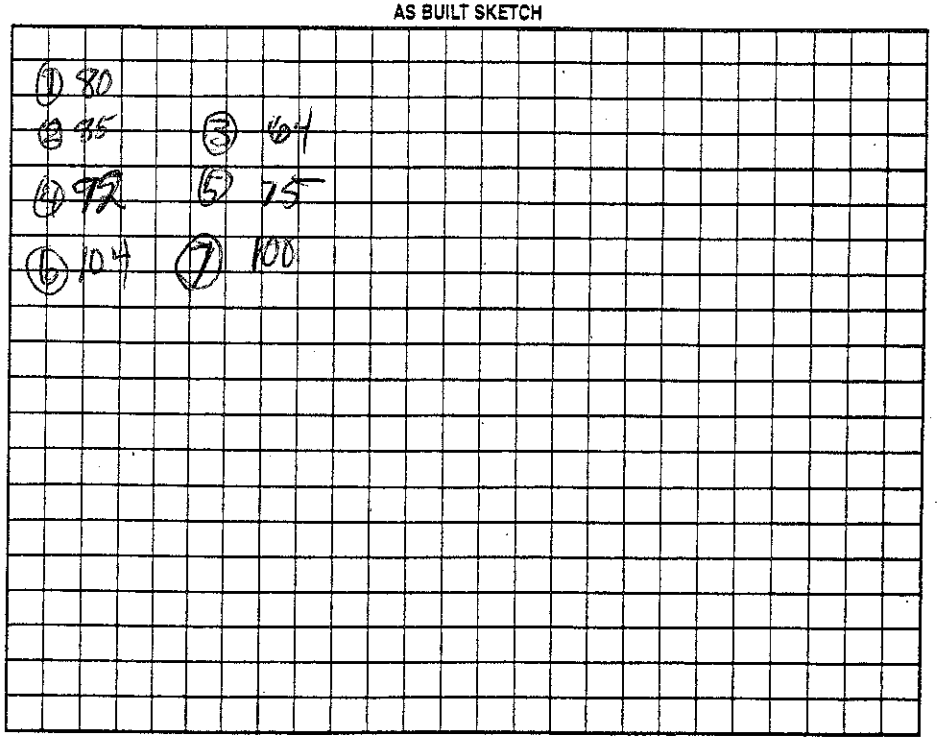

Permit can be suspended or revoked if any false information is supplied toward securing the permit/any unauthorized changes are made to the site/any unauthorized changes are made in the installation of the system. Improvement Permit with plat valid without expiration ☐ Improvement Permit with site plan valid for sixty months ☑ Authorization to Construct is valid for a period equal to that of Improvement Permit – not to exceed sixty months.

Signed: _____ date 8-14-08 Installed by: Marty Tucker

Improvement Permit by: _____ date 8-13-08 Operation Permit by: _____ date 4-23-09

Authorization to Construct by: _____ date 8-13-08 Existing System Inspection by: _____ date _____

HEALTH DEPT. COPY: WHITE OWNER COPY (FINAL): YELLOW OWNER COPY (INITIAL): PINK

1 inch equals 120 feet
LITTLE WILKESBORO RD
JOHN DEERE DR
980
960
950
940
930
920
970
766
611
683
330
328
332
272
210
180
150
110
111
154
132
131
314
316
40
90
Unsuitable
25'
102
81
Repair 25' from low area of ditch
septic and grease tank needed
N
S
E
W