IREDELL COUNTY HEALTH DEPARTMENT

STATESVILLE 704-878-5305 MOORESVILLE 704-664-5281

IMPROVEMENT PERMIT / AUTHORIZATION TO CONSTRUCT / OPERATION PERMIT / EXISTING SYSTEM INSPECTION

PERMIT# HARMONY 79.39/ PIN# DATE 12-7-98

OWNER OR CONTRACTOR HUNTING CREEK BUILDING Co. PHONE Business 539-5539 Home

ADDRESS 1000 UNION GROVE ROAD, UNION GROVE, NC 28689

LOCATION US 21 N, TL LITTLE WILKESBORO ROAD, 3RD LOT ON RIGHT PAST RABBIT HIGHWAY

SUBDIVISION HARMONY COUNTRY BLOCK / SECTION LOT 7 LOT AREA 0.660 ACRE SITE CLASS PS DESIGN FLOW 360 LTAR 0.30 GPD/FT²

Septic Tank: 1000 Gallons: STB 1012 Date 5-29-99

Pump Tank: Gallons: PT Date

Pump Make: Model: Serial No

Nitrification Field: No Fields Square Feet 1200 Linear Feet 300

No Lines FIVE Trench Width 36" Max Trench Bottom Depth 36" Depth SAND 6"

✓ New System Repair System Type I II III IV V VI

System Description 25% REDUCTION GRAVITY

Repair System Description 25% REDUCTION PUMP

Maintenance Agreement Required Yes No

✓ House/Mod Home No. Bedrooms 3

Mobile Home No. Bathrooms 2

Business No. Employees

Other


Slab Crawl Space Basement w/plumbing Basement w/o plumbing

Water Supply: ☐ Individual ☐ Public ☐ Community

Comments/Conditions ① SCOUR TRENCH SIDEWALLS & APPLY A LIGHT DUSTING OF LIME PRIOR TO INSTALLING 25% REDUCTION SYSTEM ② INSTALL 25% REDUCTION SYSTEM USING FIFTY (6') CHAMBERS OR THIRTY (10') HDS SECTIONS

Comments: Conditions

INITIAL SITE SKETCH

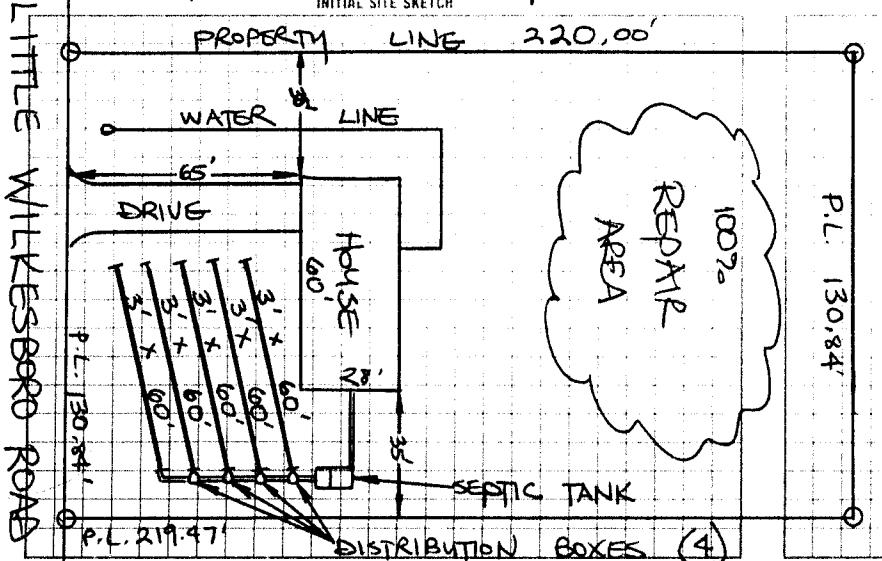

AS BUILT SKETCH

Same as initial sketch

I understand that this permit can be suspended or revoked if any false information is supplied toward securing the permit/any unauthorized changes are made to the site/any unauthorized changes are made in the installation of the system. Improvement Permit with plat valid without expiration. Improvement Permit with site plan valid for sixty months. Authorization to Construct is valid for a period equal to that of Improvement Permit – not to exceed sixty months.

Signed: Velma Kranz date 1-5-98

Improvement Permit by: STEVE HEDRICK date 12-7-98

Authorization to Construct by: STEVE HEDRICK date 12-7-98

Installed by: Tommy Frye

Operation Permit by: P.C. Moore date 8-6-99

Existing System Inspection by: date

HEALTH DEPT. COPY WHITE INSPECTION COPY (FINAL) GREEN OWNER COPY (FINAL) YELLOW INSPECTION COPY (INITIAL) PINK OWNER COPY (INITIAL) GOLD