IREDELL COUNTY HEALTH DEPARTMENT

STATESVILLE 704-878-5305 MOORESVILLE 704-664-5281

IMPROVEMENT PERMIT / AUTHORIZATION TO CONSTRUCT / OPERATION PERMIT / EXISTING SYSTEM INSPECTION

PERMIT# HARMONY 07368 PIN#

OWNER OR CONTRACTOR HUNTING CREEK BUILDING CO, INC PHONE: Business 539-5539 Home DATE 5-12-98

ADDRESS 1000 UNION GROVE ROAD, UNION GROVE, NC 28689

LOCATION US 21 N, TL LITTLE WILKESBORO ROAD, 1ST LOT ON RIGHT PAST RABBIT HIGHWAY

SUBDIVISION HARMONY COUNTRY ESTATES BLOCK / SECTION I LOT 9 LOT AREA 0.739 ACRE SITE CLASS. PS DESIGN FLOW 360 L.T.A.R. .30 GPD/FT²

Septic Tank: 1000 Gallons; STB 1012 Date 10-2-98

Pump Tank: _____ Gallons; PT _____ Date _____

Pump Make: _____ Model _____ Serial No. _____

Nitrification Field: No Fields 1 Square Feet 1200 Linear Feet 400

No Lines THREE Trench Width 36" Max Trench Bottom Depth 36" Gravel Depth 12"

☑ New System ☐ Repair System Type: I, (II), III, IV, V, VI

System Description: CONVENTIONAL GRAVITY

Repair System Description: CONV. PUMP-FED

Maintenance Agreement Required: ☐ Yes ☑ No

☑ House/Mod. Home ☐ Mobile Home ☐ Business ☐ Other

No. Bedrooms 3 No. Bathrooms 2 No. Employees _____


☐ Slab ☑ Crawl Space ☐ Basement w/plumbing ☐ Basement wo/plumbing

Water Supply: ☐ Individual ☑ Public ☐ Community

* Comments:/Conditions: SCOUR TRENCH SIDEWALLS AND APPLY A LIGHT DUSTING OF LIME PRIOR TO INSTALLATION OF STONE *

Comments:/Conditions:

INITIAL SITE SKETCH SCALE: 1" = 50'

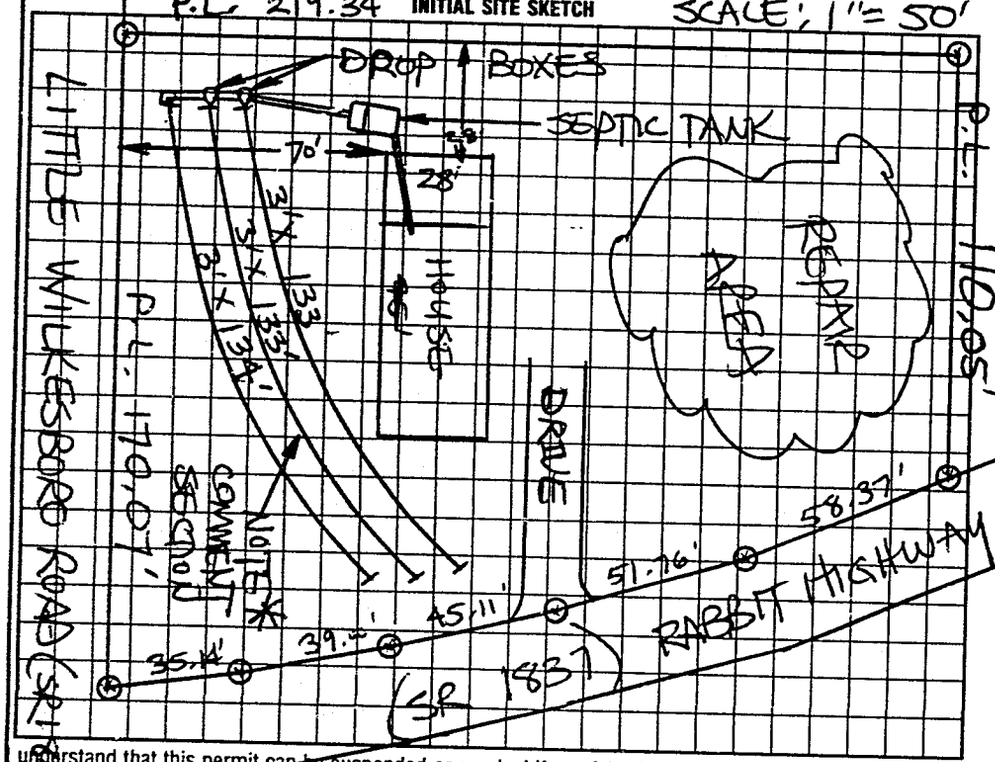

AS BUILT SKETCH

SYSTEM INSTALLED SIMILAR TO INITIAL SITE SKETCH

I understand that this permit can be suspended or revoked if any false information is supplied toward securing the permit/any unauthorized changes are made to the site/any unauthorized changes are made in the installation of the system. Improvement Permit with plat valid without expiration. Improvement Permit with site plan valid for sixty months. Authorization to Construct is valid for a period equal to that of Improvement Permit – not to exceed sixty months.

Signed: Jennifer Winkler date 5-13-98

Improvement Permit by: STEVE HEDRICK date 5-12-98

Authorization to Construct by: STEVE HEDRICK date 5-12-98

Installed by: TOMMY FRYE

Operation Permit by: STEVE HEDRICK date 10-7-98

Existing System Inspection by: _____ date _____

HEALTH DEPT. COPY: WHITE INSPECTION COPY (FINAL): GREEN OWNER COPY (FINAL): YELLOW INSPECTION COPY (INITIAL): PINK OWNER COPY (INITIAL): GOLD