IREDELL COUNTY HEALTH DEPARTMENT

STATESVILLE 704-878-5305 MOORESVILLE 704-664-5281

IMPROVEMENT PERMIT / AUTHORIZATION TO CONSTRUCT / OPERATION PERMIT / EXISTING SYSTEM INSPECTION

DATE 1-15-99

PERMIT# REPAIR PIN#

OWNER OR CONTRACTOR RALPH & RUTH CHEEK PHONE: Business Home 546-2211

ADDRESS 218 LITTLE WILKESBORO ROAD HARMONY, NC 28634

LOCATION US 21 N, TL LITTLE WILKESBORO ROAD, HOUSE ON RIGHT AT RABBIT HIGHWAY

SUBDIVISION BLOCK / SECTION LOT LOT AREA LIMITED SITE CLASS. PS DESIGN FLOW 240 L.T.A.R. EXISTING

Septic Tank: EXISTING Gallons; STB Date

Pump Tank: Gallons; PT Date

Pump Make: Model Serial No.

Nitrification Field: No Fields 1 Square Feet 360 Linear Feet 60

No Lines 1 BED Trench Width 72" Max Trench Bottom Depth 42"

[X] New System [✓] Repair System Type: I (II) III, IV, V, VI

System Description:

Repair System Description: CONV. GRAVITY

Maintenance Agreement Required: [ ] Yes [✓] No

Gravel Depth 24" [ ] Slab [✓] Crawl Space [ ] Basement w/plumbing [ ] Basement wo/plumbing

[✓] House/Mod. Home No. Bedrooms 3

[ ] Mobile Home No. Bathrooms 1

[ ] Business No. Employees


[ ] Other

Water Supply: [ ] Individual [✓] Public [ ] Community

Comments:/Conditions: ① THIS PERMIT SERVES AS NOTICE OF VIOLATION ② REPLACE SANITARY TEE IF NECESSARY

Comments:/Conditions:

INITIAL SITE SKETCH

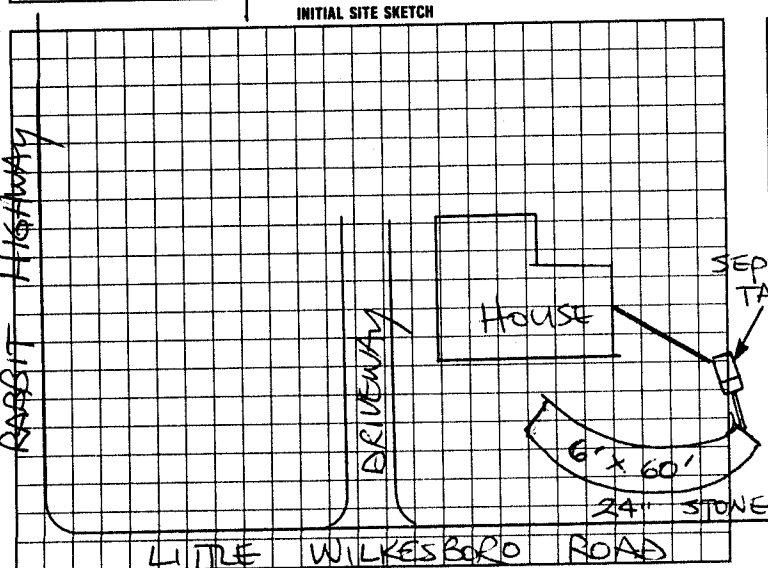

AS BUILT SKETCH

SYSTEM REPAIRED ACCORDING TO INITIAL SITE SKETCH

I understand that this permit can be suspended or revoked if any false information is supplied toward securing the permit/any unauthorized changes are made to the site/any unauthorized changes are made in the installation of the system. Improvement Permit with plat valid without expiration. Improvement Permit with site plan valid for sixty months. Authorization to Construct is valid for a period equal to that of Improvement Permit – not to exceed sixty months.

Signed: Ruth L. Cheek date 1-15-99

Improvement Permit by: STEVE HEDRICK date 1-15-99

Authorization to Construct by: STEVE HEDRICK date 1-15-99

Installed by: SAMMY REAVIS

Operation Permit by: STEVE HEDRICK date 1-20-99

Existing System Inspection by: date

HEALTH DEPT. COPY: WHITE INSPECTION COPY (FINAL): GREEN OWNER COPY (FINAL): YELLOW INSPECTION COPY (INITIAL): PINK OWNER COPY (INITIAL): GOLD