@ 10:46
Called 6-26-07, left message

IREDELL COUNTY HEALTH DEPARTMENT

STATESVILLE 704-878-5305 MOORESVILLE 704-664-5281

IMPROVEMENT PERMIT / AUTHORIZATION TO CONSTRUCT / OPERATION PERMIT / EXISTING SYSTEM INSPECTION

PERMIT# 143554 PIN# 4871-42-1602 DATE 6-21-07

OWNER OR APPLICANT JOHN DISHMAN PHONE: Business 704-490-2003 Home

ADDRESS 3204 IAN PATRICK AVE, KANNAPOLIS, NC 28083

LOCATION US 21 N, TL LITTLE WILKESBORO Hwy, TR RABBIT Hwy, TL TRANQUILITY LANE, 5TH LOT ON RIGHT

SUBDIVISION HARMONY COUNTRY BLOCK / SECTION ____ LOT 37 LOT AREA 2.063 ACRES SITE CLASS. PS DESIGN FLOW 360 L.T.A.R. 0.20 GPD/FT²

Septic Tank: 1000 Gallons; STB 7160 Date 6/19/07
Pump Tank: 1000 Gallons; PT 3103 Date 9/28/07
Pump Make: Zoeller 1HP Model N57-0 Serial No. 57-0029
Nitrification Field: No Fields 1 Square Feet 1800 Linear Feet 450
No Lines THREE Trench Width 36" Max Trench Bottom Depth 28

☑ New System ☐ Repair ☐ Expansion System Type: I II III IV V VI
System Description: 25% REDUCTION, PUMP
Repair System Description: 50% REDUCTION, LOW PRESSURE
Maintenance Agreement Required: ☐ Yes ☑ No ☐ Other
Gravel Depth N/A ☐ Gravity ☑ Pressure ☐ Slab ☑ Crawl Space ☐ Basement w/plumbing ☐ Basement wo/plumbing

☑ House/Mod. Home No. Bedrooms 3
☐ Mobile Home No. Persons ____
☐ Business No. Employees ____

Water Supply: ☑ Individual ☐ Public ☐ Community WELL

Comments:/Conditions:

Comments:/Conditions:

INITIAL SITE SKETCH

SEE ATTACHED "FAST TRACK" SITE PLAN" PREPARED BY MICHAEL ATHANAS & ASSOC. INC.

AS BUILT SKETCH

Septic Mound

Red Rolly Rock

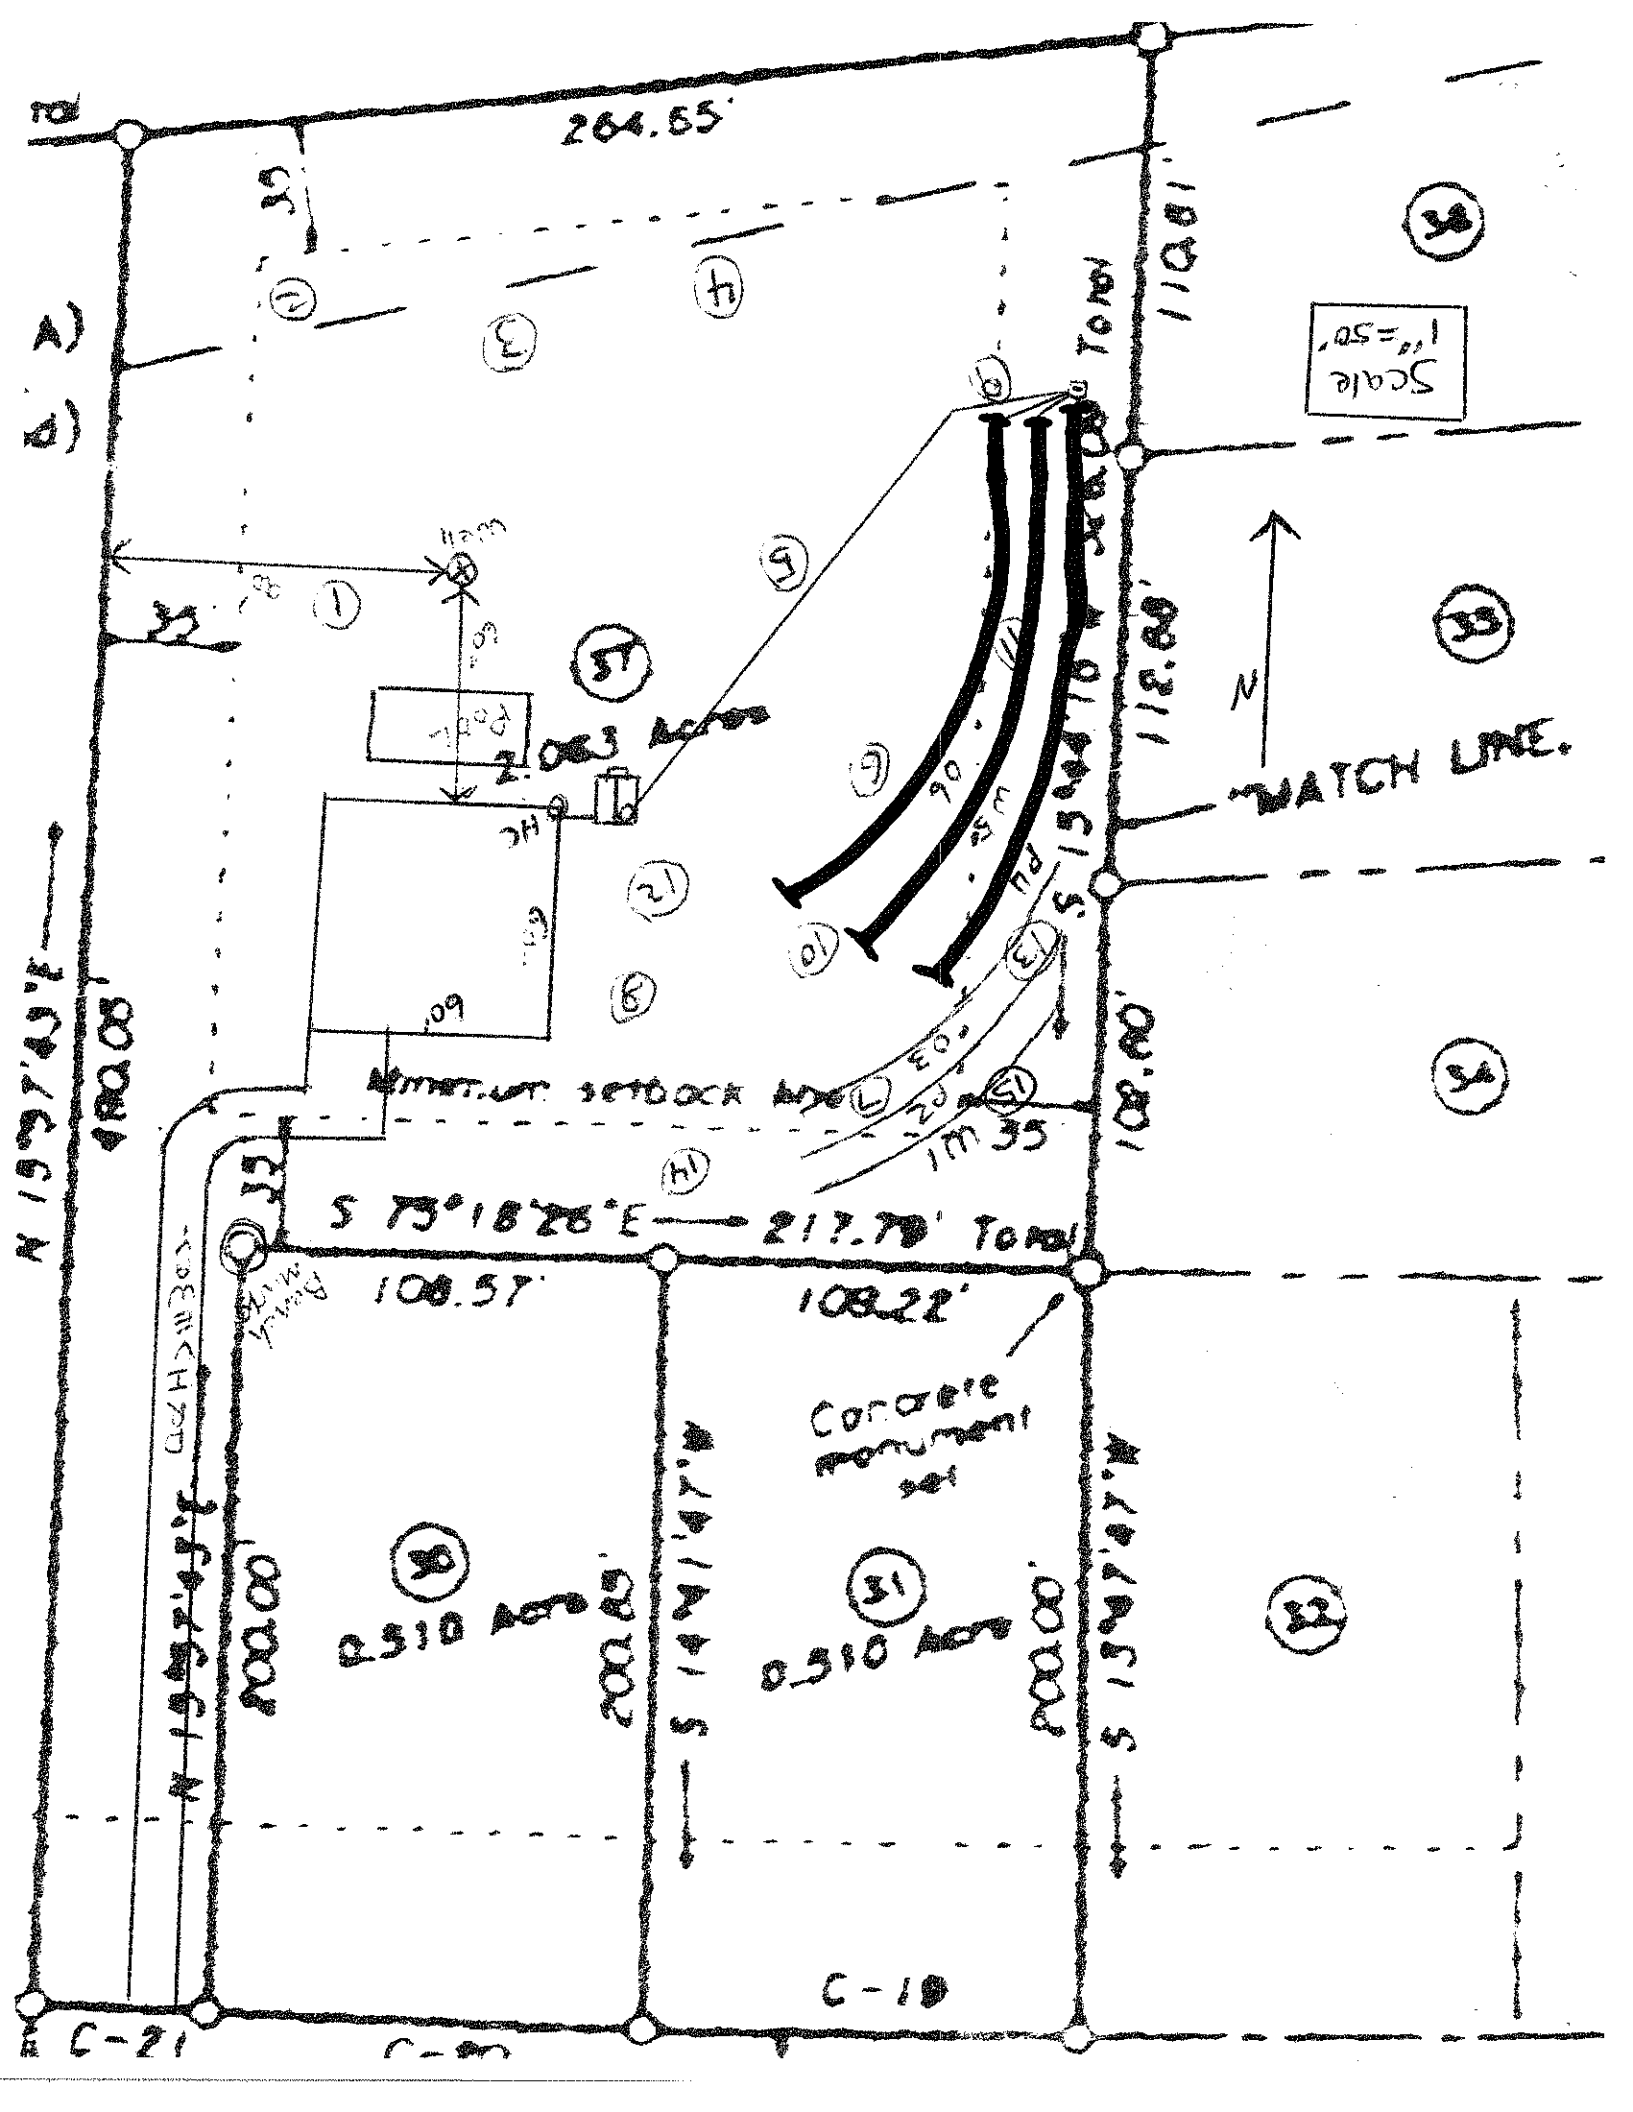
Permit can be suspended or revoked if any false information is supplied toward securing the permit/any unauthorized changes are made to the site/any unauthorized changes are made in the installation of the system. Improvement Permit with plat valid without expiration. ☐ Improvement Permit with site plan valid for sixty months ☑ Authorization to Construct is valid for a period equal to that of Improvement Permit – not to exceed sixty months.

Signed: _____ date 6/26/07 Installed by: Madison Grading

Improvement Permit by: STEVE HEDRICK date 6-21-07 Operation Permit by: _____ date 3-18-08

Authorization to Construct by: STEVE HEDRICK date 6-21-07 Existing System Inspection by: _____ date _____

HEALTH DEPT. COPY: WHITE OWNER COPY (FINAL): YELLOW OWNER COPY (INITIAL): PINK


264.55'
Scale 1"=50'
WATCH LINE.
N
S 75°18'26"E — 217.79' TOMB
108.51'
108.21'
Concrete monument set
0.510 Acres
0.510 Acres
C-18
C-21
C-20
34
35
