IREDELL COUNTY HEALTH DEPARTMENT

STATESVILLE 704-878-5305 (a) MOORESVILLE 704-664-5281

IMPROVEMENT PERMIT / AUTHORIZATION TO CONSTRUCT / OPERATION PERMIT / EXISTING SYSTEM INSPECTION

PERMIT# 125823 PIN# 4871-42-2046 DATE 2-7-05

OWNER OR CONTRACTOR GARLAND HOMES INC. PHONE: Business (704) 902-9492 Home

ADDRESS 310 WINDING SHORE RD TROUTMAN NC 28166

LOCATION I-77N TO HWY 901 (EXIT 65) TR ON HWY 901 TL LITTLE WILKESBORO TL RABBIT TL TRANQUILITY ON LEFT

SUBDIVISION HARMONY COUNTRY EST BLOCK / SECTION II LOT 11 LOT AREA 0.536 SITE CLASS PS DESIGN FLOW 360 L.T.A.R. 0.25 gpd/Ft

Septic Tank: 1000 Gallons; STB 1007 Date 6-17-05

Pump Tank: ____ Gallons; PT ____ Date ____

Pump Make: ____ Model ____ Serial No. ____

Nitrification Field: No Fields 1 Square Feet 1440 Linear Feet 360

No Lines 6 Trench Width 36" Max Trench Bottom Depth 30" Gravel Depth N/A

☑ New System ☐ Repair System Type: I, II, (III) IV, V, VI

System Description: GRAVITY 25% REDUCTION

Repair System Description: LP PANEL 50% REDUCTION

Maintenance Agreement Required: ☐ Yes ☑ No

☑ House/Mod. Home No. Bedrooms 3

☐ Mobile Home No. Bathrooms ____

☐ Business No. Employees ____

☐ Other ____


☐ Slab ☑ Crawl Space ☐ Basement w/plumbing ☐ Basement wo/plumbing

Water Supply: ☐ Individual ☑ Public ☐ Community


Comments:/Conditions (1) INSTALL LINES NO DEEPER THAN 30" ON CONTOUR (2) MAINTAIN ALL SETBACKS (3) DO NOT CUT DRIVEWAY OR PERMIT WILL BE VOID.

Comments:/Conditions: SEPTIC TANK WITH A MARKER INSTALLED USING "ZABEL" FILTER

INITIAL SITE SKETCH

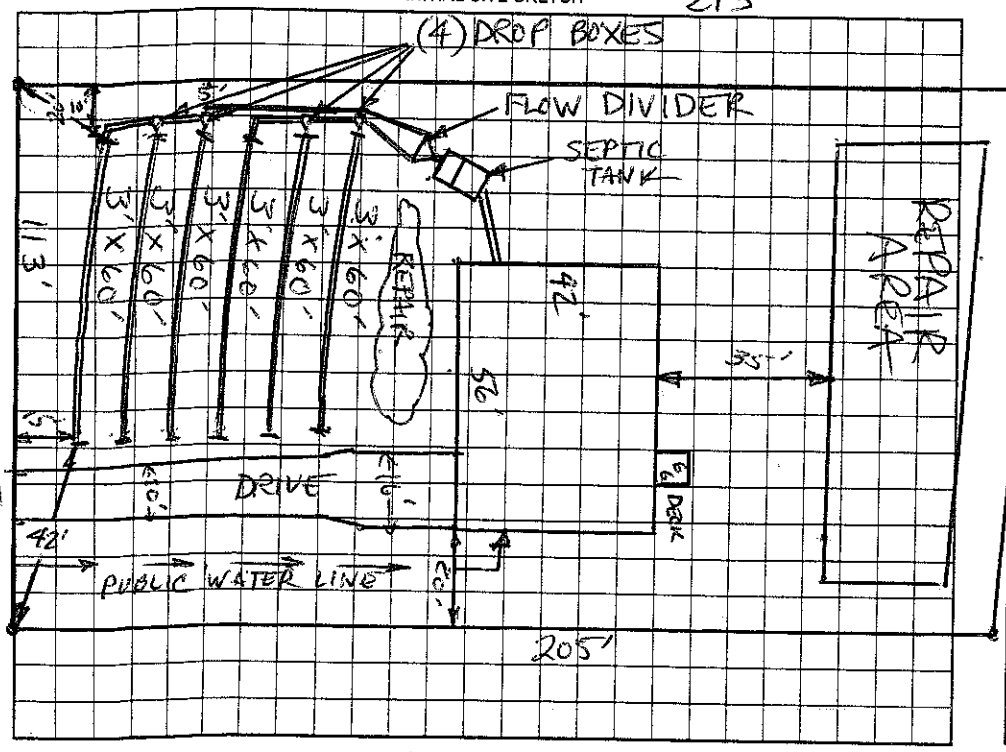

AS BUILT SKETCH

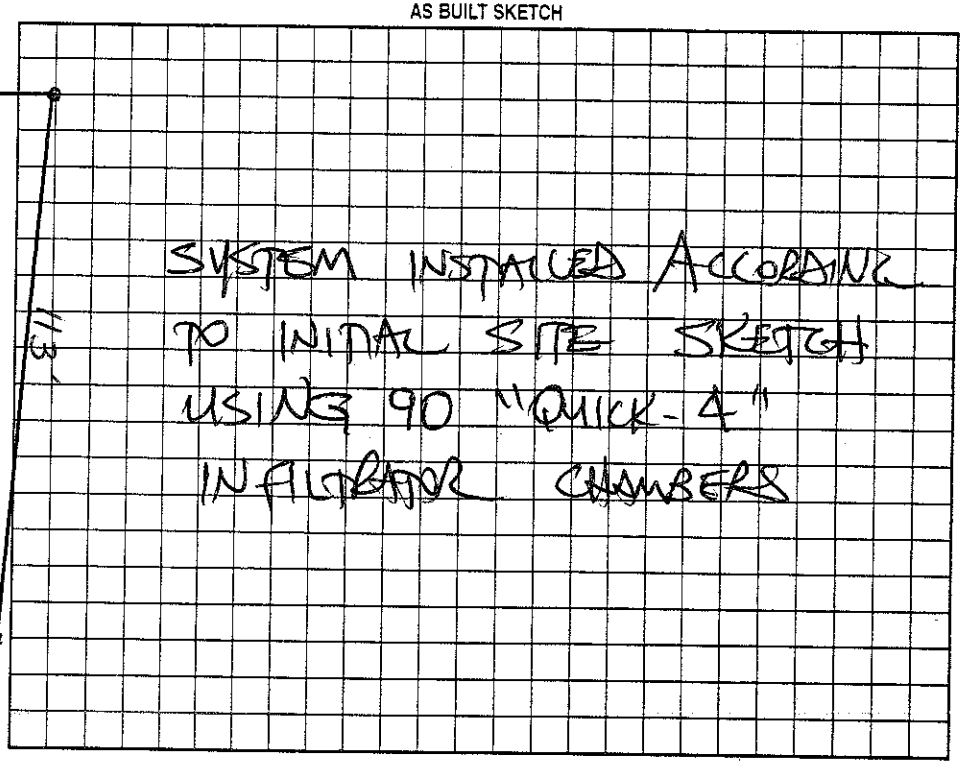

Permit can be suspended or revoked if any false information is supplied toward securing the permit/any unauthorized changes are made to the site/any unauthorized changes are made in the installation of the system. Improvement Permit with plat valid without expiration. Improvement Permit with site plan valid for sixty months. Authorization to Construct is valid for a period equal to that of Improvement Permit – not to exceed sixty months.

Signed: ____ date 2-10-05

Improvement Permit by: [signature] RS, LSS date 2-7-05

Authorization to Construct by: [signature] RS, LSS date 2-7-05

Installed by: KEVIN SIGMON (KEEP'S)

Operation Permit by: STEVE HEDRICK date 7-12-05

Existing System Inspection by: ____ date ____

HEALTH DEPT. COPY: WHITE OWNER COPY (FINAL): YELLOW OWNER COPY (INITIAL): PINK