IREDELL COUNTY HEALTH DEPARTMENT

STATESVILLE 704-878-5305 MOORESVILLE 704-664-5281

IMPROVEMENT PERMIT / AUTHORIZATION TO CONSTRUCT / OPERATION PERMIT / EXISTING SYSTEM INSPECTION

PERM# 13122 PIN# 4814423062 DATE 9-13-05

OWNER OR CONTRACTOR Jamie Watman PHONE: Business 704-655-9548 Home

ADDRESS 452 3 Main St Suite 130 Mooresville NC 28115

LOCATION 21N Harmony to Little Wilson RD (R) Rabbit Ridge TO Tranquility LN 1st on Corner

SUBDIVISION Memory Crossing Estates BLOCK / SECTION LOT 10 LOT AREA 1.02 SITE CLASS B DESIGN FLOW 360 L.T.A.R. 13

Septic Tank: 1000 Gallons; STB 1012 Date 2-23-05

Pump Tank: Gallons; PT Date

Pump Make: Model Serial No.

Nitrification Field: No Fields Square Feet 1200 Linear Feet 300

No Lines 4 Trench Width 36" Max Trench Bottom Depth 24" Gravel Depth NA

☐ New System ☐ Repair System Type: I II III IV V VI

System Description: 25% Expansion

Repair System Description: 25% Reduction

Maintenance Agreement Required: ☐ Yes ☐ No

☐ House/Mod. Home No. Bedrooms 3

☐ Mobile Home No. Bathrooms

☐ Business No. Employees

☐ Other


☐ Slab ☐ Crawl Space ☐ Basement w/plumbing ☐ Basement wo/plumbing

Water Supply: ☐ Individual ☐ Public ☐ Community

Comments:/Conditions: Located on Contour
Maintain all setbacks

Comments:/Conditions:
Yellow tuff tite filter
Septic tank Manhole installed

INITIAL SITE SKETCH

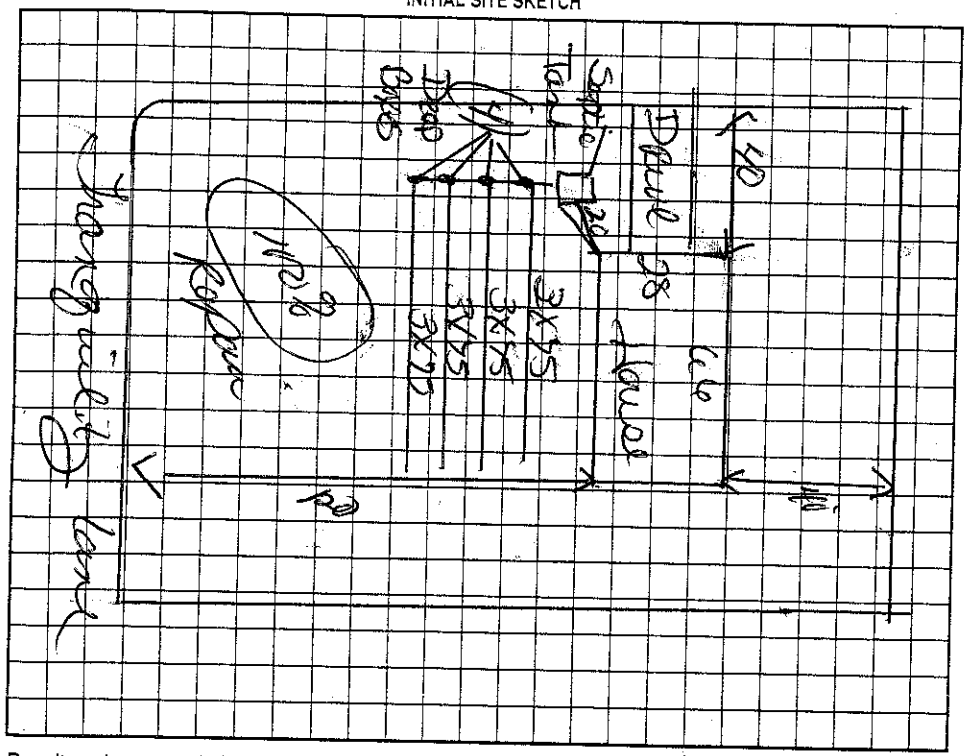

AS BUILT SKETCH

Permit can be suspended or revoked if any false information is supplied toward securing the permit/any unauthorized changes are made to the site/any unauthorized changes are made in the installation of the system. Improvement Permit with plat valid without expiration. Improvement Permit with site plan valid for sixty months. Authorization to Construct is valid for a period equal to that of Improvement Permit – not to exceed sixty months.

Signed: date

Improvement Permit by: date 9-13-05

Authorization to Construct by: date 9-13-05

Installed by: A-1 backhoe

Operation Permit by: date 9-15-05

Existing System Inspection by: date

HEALTH DEPT. COPY: WHITE OWNER COPY (FINAL): YELLOW OWNER COPY (INITIAL): PINK