IREDELL COUNTY HEALTH DEPARTMENT

STATESVILLE 704-878-5305 MOORESVILLE 704-664-5281

IMPROVEMENT PERMIT / AUTHORIZATION TO CONSTRUCT / OPERATION PERMIT / EXISTING SYSTEM INSPECTION

PERMIT# REPAIR PIN# DATE 9-8-99

OWNER OR CONTRACTOR HARMONY BAPTIST CHURCH PHONE: Business Home E. EDMISTEN - 546-7555

ADDRESS 3470 HARMONY HIGHWAY, HARMONY NC 28634

LOCATION US 21 NORTH, 2ND HOUSE ON RIGHT PAST HAYES STREET AT BOX # 3470

SUBDIVISION BLOCK / SECTION LOT LOT AREA LIMITED SITE CLASS PS DESIGN FLOW 360 L.T.A.R. EXISTING

Septic Tank: 1000 (EXISTING) Gallons; STB Date

Pump Tank: Gallons; PT Date

Pump Make: Model Serial No

Nitrification Field: No Fields 1 Square Feet 600 Linear Feet 200

No Lines THREE Trench Width 36" Max Trench Bottom Depth 35"

☐ New System ☑ Repair System Type: I (II) III IV V VI

System Description:

Repair System Description: CONVENTIONAL GRAVITY

Maintenance Agreement Required ☐ Yes ☑ No

Gravel Depth (18") ☐ Slab Crawl Space ☑ Basement w/plumbing ☐ Basement wo/plumbing

☑ House/Mod. Home No. Bedrooms 3

☐ Mobile Home No. Bathrooms 2

☐ Business No Employees


☐ Other

Water Supply: ☐ Individual ☑ Public ☐ Community

Comments/Conditions: ① EXCAVATE EXISTING LINES AT LOCATION SHOWN AND DAM UP USING CLEAN RED CLAY ② INSTALL NEW LINES AS FLAGGED AS SHALLOW AS POSSIBLE (INTERSECTING OLD LINE)

Comments/Conditions: SYSTEM TO BE REPAIRED BY 10-8-99 THIS PERMIT SERVES AS NOTICE OF VIOLATION

INITIAL SITE SKETCH ~ SCALE: 1"=40'

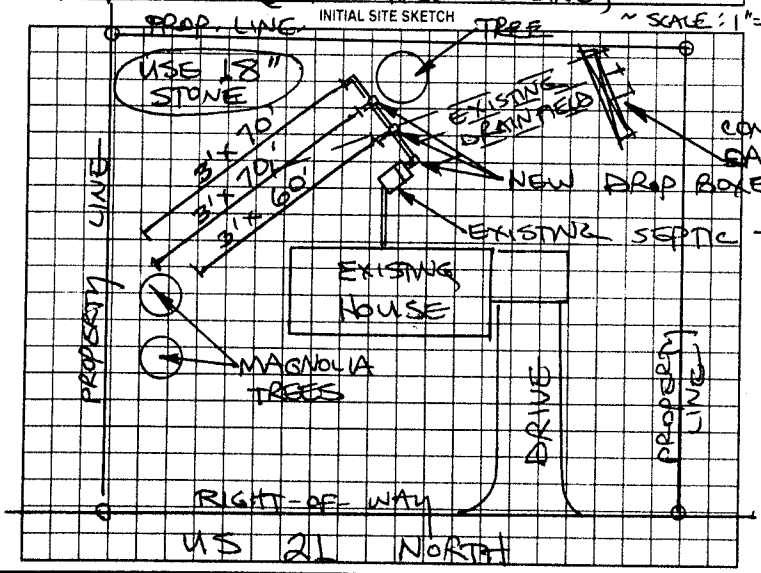

AS BUILT SKETCH

SYSTEM REPAIRED ACCORDING TO INITIAL SITE SKETCH

Permit can be suspended or revoked if any false information is supplied toward securing the permit/any unauthorized changes are made to the site/any unauthorized changes are made in the installation of the system. Improvement Permit with plat valid without expiration. Improvement Permit with site plan valid for sixty months. Authorization to Construct is valid for a period equal to that of Improvement Permit – not to exceed sixty months.

Signed: [signature] date 9-9-99 Installed by: SAMMY REAVIS

Improvement Permit by: STEVE HEDRICK date 9-8-99 Operation Permit by: STEVE HEDRICK date 9-21-99

Authorization to Construct by: STEVE HEDRICK date 9-8-99 Existing System Inspection by: date

HEALTH DEPT COPY: WHITE OWNER COPY (FINAL) YELLOW OWNER COPY (INITIAL) PINK