IREDELL COUNTY HEALTH DEPARTMENT

Statesville Phone TR 3-7271 Mooresville Phone NO 3-1271

PERMIT TO INSTALL SEPTIC TANK

Permit NO._____ Permit Date Jan. 9 19 63

Owner Hanny Septic Pump Address Hanny

Installed By Ray Smith Address Statesville

Location of Propert Fifth House on Right Past


School Rd. in Hanny

Tank		Capacity		Length of Lines		Fixtures	
Block	( )	800	( )	150'	( )	No. of Baths	(1½
Precast	( )	900	( )	175'	( )	Dishwasher	( )
Pond		1000	(✓)	200'	( )	Garbage Grdr.	( )
		1100	( )	225'	(✓)	Auto-Washer	( )
		1200	( )	250'	( )	Other_____	
		Other_____		Other_____			

NOTIFY HEALTH DEPARTMENT AT LEAST EIGHT HOURS BEFORE TANK IS TO BE INSPECTED.

Final Inspection well 1-9 19 63 Approved (✓) Disapproved ( )

Remarks Q 5-5-4x

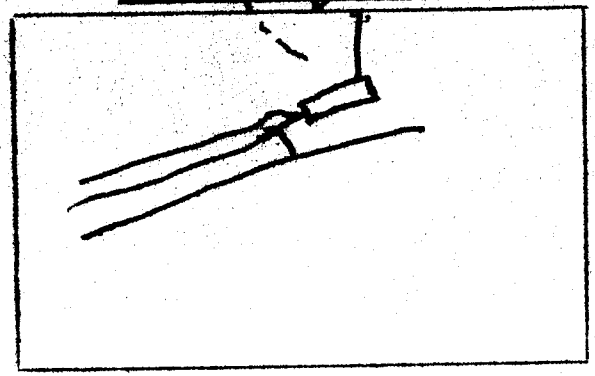

Sketch of Installation

Rod.

Sanitarian