IREDELL COUNTY HEALTH DEPARTMENT

STATESVILLE 704-878-5305 MOORESVILLE 704-664-5281

IMPROVEMENT PERMIT / AUTHORIZATION TO CONSTRUCT / OPERATION PERMIT / EXISTING SYSTEM INSPECTION

PERMIT# 12980H20 PIN# 4877544872 0811 DATE 7-25-05

OWNER OR CONTRACTOR David Reavis PHONE: Business Home 704-546-2757

ADDRESS 250 Rabbit Highway Harmony NC 28634

LOCATION 21 North to Little Willeford to Rabbit Highway (R) Chevy Lane 250 Rabbit Highway

SUBDIVISION BLOCK / SECTION LOT LOT AREA 1.3 Ac SITE CLASS: S5 DESIGN FLOW 480 L.T.A.R. .3

Septic Tank: 1000 Gallons; STB 500 Date 4-5-06

Pump Tank: Gallons; PT Date

Pump Make: Model Serial No.

Nitrification Field: No Fields 1 Square Feet 1600 Linear Feet 538

No Lines 5 Trench Width 36" Max Trench Bottom Depth 36" Gravel Depth 12"

☑ New System ☐ Repair System Type: I, II, III, IV, V, VI

System Description: Conventional Gravel

Repair System Description: Conventional Gravity

Maintenance Agreement Required: ☐ Yes ☑ No

☑ House/Mod. Home No. Bedrooms 4

☐ Mobile Home No. Bathrooms

☐ Business No. Employees


☐ Other

☐ Slab ☐ Crawl Space ☑ Basement w/plumbing ☐ Basement wo/plumbing

Water Supply: ☑ Individual ☐ Public ☐ Community


Comments/Conditions: Install on Contour well 100' away from septic

INITIAL SITE SKETCH

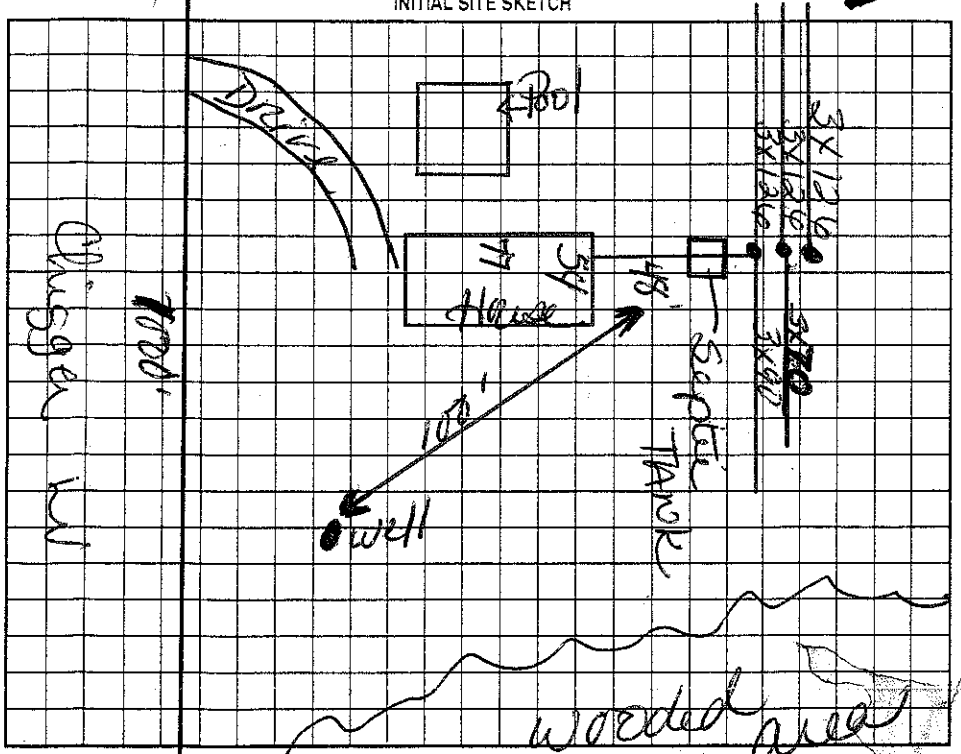

Comments/Conditions: Accepted Systems may also be used Yellow Sheet Line Letter

AS-BUILT SKETCH

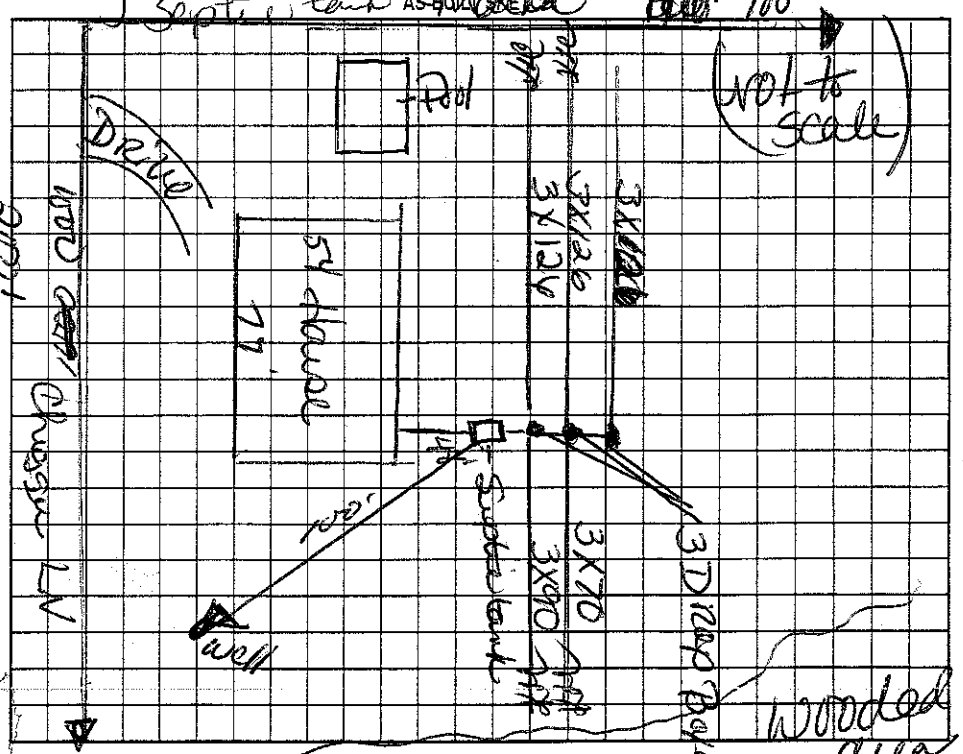

Permit can be suspended or revoked if any false information is supplied toward securing the permit/any unauthorized changes are made to the site/any unauthorized changes are made in the installation of the system. Improvement Permit with plat valid without expiration. Improvement Permit with site plan valid for sixty months. Authorization to Construct is valid for a period equal to that of Improvement Permit – not to exceed sixty months.

Signed: David Reavis date 7-29-05 Installed by: Jimmy Reavis

Improvement Permit by: Kelly Cook date 7-25-05 Operation Permit by: Kelly Cook date 8-7-06

Authorization to Construct by: Kelly Cook date 7-25-05 Existing System Inspection by: date

HEALTH DEPT. COPY: WHITE OWNER COPY (FINAL): YELLOW OWNER COPY (INITIAL): PINK