330

IREDELL COUNTY HEALTH DEPARTMENT

STATESVILLE 704-878-5305 MOORESVILLE 704-664-5281

IMPROVEMENT PERMIT / CERTIFICATE OF COMPLETION / OPERATION PERMIT / EXISTING SYSTEM INSPECTION

PROPERTY DESCRIPTION NO. HARMONY DATE 2-21-97 TAX MAP NO. Watershed: ☐ Yes ☑ No

OWNER OR CONTRACTOR JOHNNY IRELAND PHONE: Business Home 546-2761

ADDRESS 129 HAYES STREET HARMONY, NC 28634

LOCATION US 21 N, TR HAYES STREET, 7th LOT ON RIGHT

SUBDIVISION BLOCK / SECTION LOT 7 LOT AREA ~110' X 135' SITE CLASS. PS DESIGN FLOW 240 L.T.A.R. 0.30 GPD/FT²

Septic Tank: 1000 Gallons; STB 10/12 Date 1-10 97

Pump Tank: Gallons; PT Date

Pump Make: Model Serial No.

Nitrification Field: No. Fields 1 Square Feet EQ. TO 240 Linear Feet 210'

No. Lines FOUR Trench Width Max Trench Bottom Depth Gravel Depth

☑ New System ☐ Repair System Type: I, II, (III), IV, V, VI

System Description: CHAMBERED GRAVITY

Repair System Description: CHAMBERED PUMP

Maintenance Agreement Required: ☐ Yes ☑ No

☐ House/Mod. Home ☑ Mobile Home ☐ Business ☐ Other

No. Bedrooms 3 No. Bathrooms 2 No. Employees


☐ Slab ☑ Crawl Space ☐ Basement w/plumbing ☐ Basement wo/plumbing

Water Supply: ☐ Individual ☐ Community ☑ Public


Comments: ① INSTALL 35 CHAMBERS IN FOUR LINES AS FLAGGED ON SITE ② USE ONE DIST. BOX FOR SERIAL DISTRIBUTION

Comments:

INITIAL SITE SKETCH SCALE: 1" = 30'

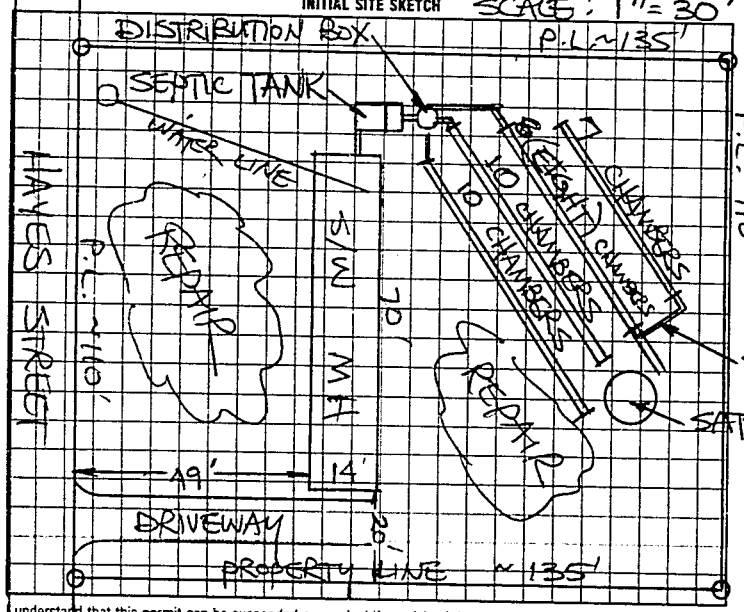

AS BUILT SKETCH

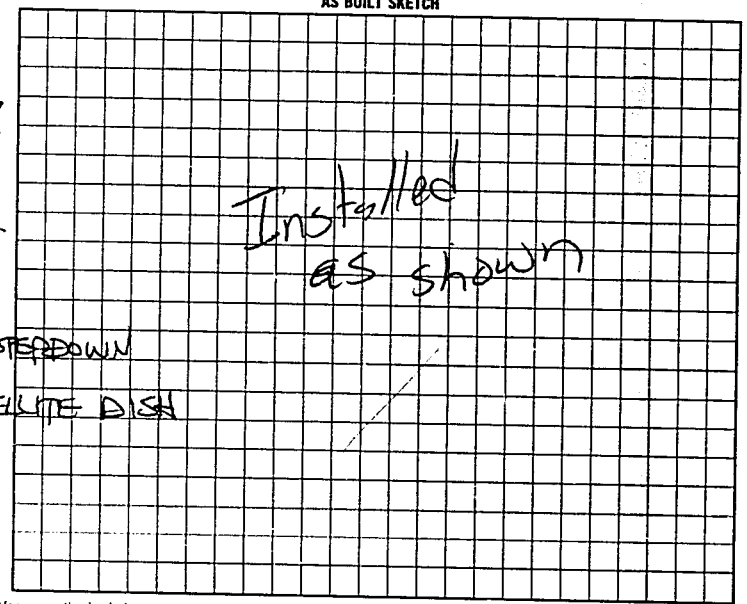

I understand that this permit can be suspended or revoked if any false information is supplied toward securing the permit/any unauthorized changes are made to the site/any unauthorized changes are made in the installation of the system. Improvement Permit is valid for 60 months from date of issuance. AUTH. TO CONST. IS VALID FOR 60 MONTHS FROM DATE OF ISSUANCE.

Signed: Johnny Ireland

Improvement Permit by: STEVE HEDRICK date 2-21-97

AUTH. TO CONST. ~~Existing System Inspection~~ by: STEVE HEDRICK date 2-21-97

Installed by: TOMMY FRYE

~~Certificate of Completion~~ by: date

Operation Permit by: Mary C Ont ICS date 3-27-97

HEALTH DEPT COPY WHITE INSPECTION COPY (FINAL) GREEN OWNER COPY (FINAL) YELLOW INSPECTION COPY (INITIAL) PINK OWNER COPY (INITIAL) GOLD