IREDELL COUNTY HEALTH DEPARTMENT

Statesville Phone TR 3-7271 Mooresville Phone No. 664-5281

PERMIT TO INSTALL SEPTIC TANK

Permit No. _____ Permit Date 20 July 1973

Owner Jimmy Reavis Address Harmony N.C.

Installed By Jimmy Reavis Address Harmony N.C.


Location of Property 21W thru Harmony - Take 1st Left After Harmony city Limits

Tank		Capacity		Length of Lines		Fixtures	
Block	( )	1000	(✓)	225'	(✓)	No. of Baths	(1)
Precast	(✓)	1250	( )	250'	( )	Dishwasher	(-)
		1500	( )	Other _____		Garbage Grdr.	(-)
		Other _____				Other _____	

NOTIFY HEALTH DEPARTMENT AT LEAST EIGHT HOURS BEFORE TANK IS TO BE INSPECTED.

Final Inspection 20 July 1973 Approved (✓) Disapproved ( )

Remarks County Water System

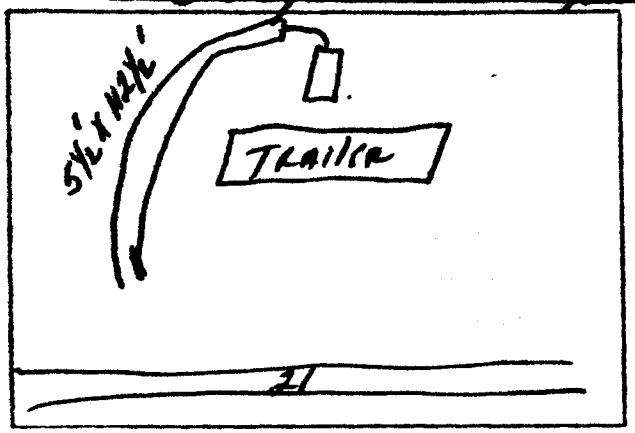

Sketch of Installation

At end of drain line, very little cover.

William M. Thrash

Sanitarian