THIS PERMIT VOIDS PREVIOUS ISSUED 6/23/93

IREDELL COUNTY HEALTH DEPARTMENT

STATESVILLE 704-878-5305 MOORESVILLE 704-664-5281

IMPROVEMENT PERMIT / AUTHORIZATION TO CONSTRUCT / OPERATION PERMIT / EXISTING SYSTEM INSPECTION

PERMIT# 078621 PIN# 4971 58 8964 DATE 1-15-99

OWNER OR CONTRACTOR JACKSON JONES PHONE: Business Home 546-7494

ADDRESS 160 COUNTRY SIDE ROAD, HARMONY, NC 28634

LOCATION US 21 N, TL COUNTRY SIDE ROAD, 0.3 MILE ON LEFT.

SUBDIVISION BLOCK / SECTION LOT LOT AREA 14.10 ACRES SITE CLASS PS DESIGN FLOW 360 L.T.A.R. 0.30 GAD/FT²

Septic Tank: 1000 Gallons; STB 1012 Date 11-23-98

Pump Tank: Gallons; PT Date

Pump Make: Model Serial No.

Nitrification Field: No Fields 1 Square Feet 1200 Linear Feet 400

No Lines FOUR Trench Width 36" Max Trench Bottom Depth 36" Gravel Depth 12"

[✓] New System [ ] Repair System Type: I, II, III, IV, V, VI

System Description: CONVENTIONAL GRAVITY

Repair System Description:

Maintenance Agreement Required: [ ] Yes [✓] No

[ ] House/Mod. Home No. Bedrooms 3

[✓] Mobile Home No. Bathrooms 2

[ ] Business No. Employees

[ ] Other


[ ] Slab [✓] Crawl Space [ ] Basement w/plumbing [ ] Basement wo/plumbing

Water Supply: [✓] Individual [ ] Public [ ] Community WELL

Comments:/Conditions:

Comments:/Conditions: POLYLOK FILTER INSTALLED IN OUTLET OF SEPTIC TANK

INITIAL SITE SKETCH

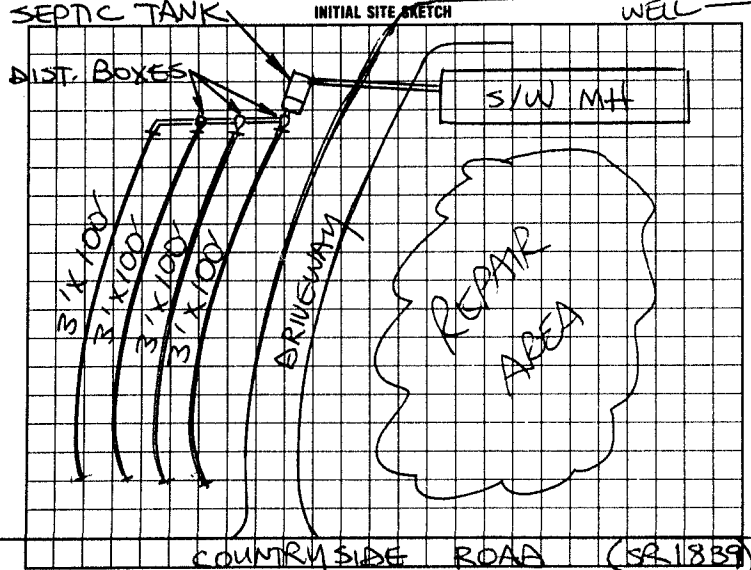

AS BUILT SKETCH

SYSTEM INSTALLED ACCORDING TO INITIAL SITE SKETCH

I understand that this permit can be suspended or revoked if any false information is supplied toward securing the permit/any unauthorized changes are made to the site/any unauthorized changes are made in the installation of the system. Improvement Permit with plat valid without expiration. Improvement Permit with site plan valid for sixty months. Authorization to Construct is valid for a period equal to that of Improvement Permit – not to exceed sixty months.

Signed: Tommy L Jones date 1-15-99 Installed by: Tommy Frye

Improvement Permit by: STEVE HENDRICK date 1-15-99 Operation Permit by: STEVE HENDRICK date 1-22-99

Authorization to Construct by: STEVE HENDRICK date 1-15-99 Existing System Inspection by: date

HEALTH DEPT. COPY: WHITE INSPECTION COPY (FINAL): GREEN OWNER COPY (FINAL): YELLOW INSPECTION COPY (INITIAL): PINK OWNER COPY (INITIAL): GOLD