IREDELL COUNTY HEALTH DEPARTMENT

STATESVILLE 704-878-5305 MOORESVILLE 704-664-5281

IMPROVEMENT PERMIT / AUTHORIZATION TO CONSTRUCT / OPERATION PERMIT / EXISTING SYSTEM INSPECTION

PERMIT# 116201 PIN# 4871-70-4832 704-437-4545 DATE 10-15-03

OWNER OR CONTRACTOR TRINA DALTON PHONE: Business 704-880-9970 Home 704-437-3625

ADDRESS 184 HAYES ST HARMONY, NC 28634

LOCATION 21 NORTH THRU HARMONY, (R) HAYES ST, (L) AT BOX # 184

SUBDIVISION GAITHER PROPERTY SECTION LOT 18 LOT AREA SITE CLASS. DESIGN FLOW 240 L.T.A.R. EXISTING

Septic Tank: 1500 Gallons; STB Date

Pump Tank: Gallons; PT Date

Pump Make: Model Serial No.

Nitrification Field: No Fields 1 Square Feet 1440 Linear Feet 480'

No Lines 4 Trench Width / Max Trench Bottom Depth / Gravel Depth 12"

☐ New System ☐ Repair System Type: I (II) III, IV, V, VI

System Description: CONV GRAV EXISTING

Repair System Description:

Maintenance Agreement Required: ☐ Yes ☐ No

☐ House/Mod. Home ☒ Mobile Home ☐ Business ☐ Other

No. Bedrooms 2 No. Bathrooms 2 No. Employees


☐ Slab ☐ Crawl Space ☐ Basement w/plumbing ☐ Basement wo/plumbing

Water Supply: ☐ Individual ☒ Public ☐ Community


Comments:/Conditions: (1) SYSTEM DESIGNED + PERMITTED 11-15-85 FOR 2 MOBILE HOMES WITH 2 BEDROOMS & 2 BATHROOMS EACH. (2) SYSTEM FUNCTIONING PROPERLY AT TIME OF CHECK (3) MOBILE HOME

Comments:/Conditions: ALREADY SET UP AT TIME OF CHECK IN SAME LOCATION AS OLD 14X76' WAS SITTING. (4) TOOK OFF 2 BEDROOM & PUTTING ON A 2 BEDROOM

INITIAL SITE SKETCH

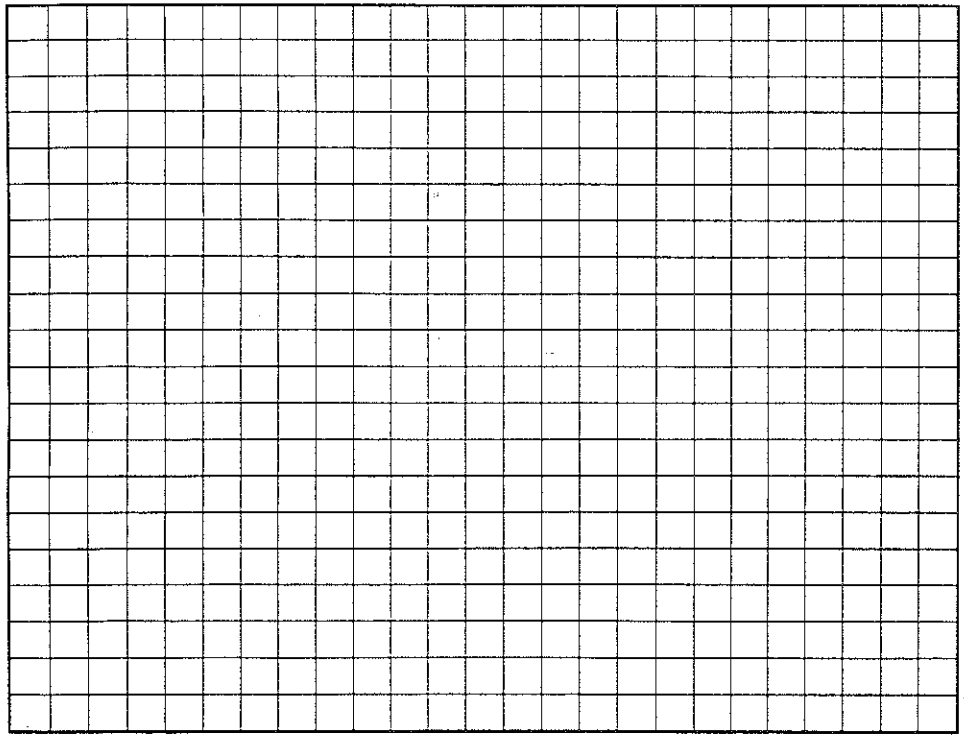

AS BUILT SKETCH

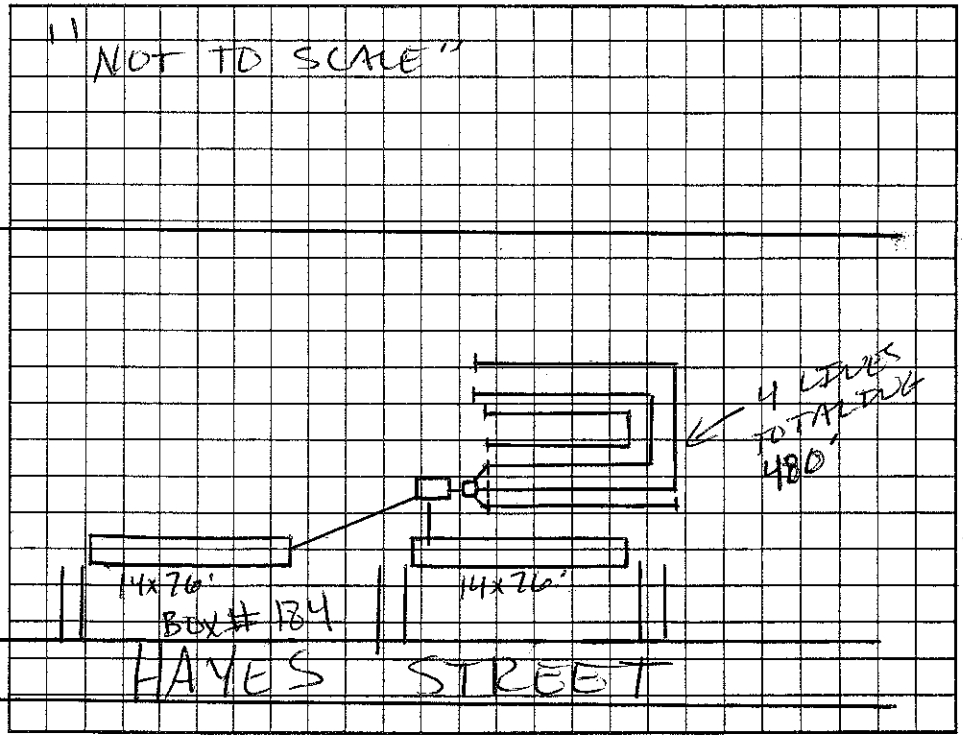

Permit can be suspended or revoked if any false information is supplied toward securing the permit/any unauthorized changes are made to the site/any unauthorized changes are made in the installation of the system. Improvement Permit with plat valid without expiration. Improvement Permit with site plan valid for sixty months. Authorization to Construct is valid for a period equal to that of Improvement Permit – not to exceed sixty months.

Signed: Jerald Dalton date Installed by: SELF & CO

Improvement Permit by: date Operation Permit by: date

Authorization to Construct by: date Existing System Inspection by: date 10-15-03

HEALTH DEPT. COPY: WHITE OWNER COPY (FINAL): YELLOW OWNER COPY (INITIAL): PINK