Dd #50 fee to Health Dept

IREDELL COUNTY HEALTH DEPARTMENT

STATESVILLE 704-878-5305 MOORESVILLE 704-664-5281

IMPROVEMENT PERMIT / CERTIFICATE OF COMPLETION / OPERATION PERMIT / EXISTING SYSTEM INSPECTION

PROPERTY DESCRIPTION NO. 89240 DATE 6/11/93 TAX MAP NO 4-12N-2B-22A

OWNER OR CONTRACTOR LARRY C. SHAVER, JR. PHONE: Business Home 546-7959

ADDRESS RT. 2, Box 143-A, HARMONY, NC 28634

LOCATION US 21 N, TR HAYES STREET, 17th LOT ON PS (R)

SUBDIVISION BLOCK / SECTION LOT 17 LOT AREA SITE CLASS. PS L.T.A.R. 0.33 GAD/FT²

Water Supply: ☐ Individual ☐ Community ☑ Public

Septic Tank: EXISTING Gallons; STB 1500 GAL Date

Pump Tank: Gallons; PT Date

Nitrification Field: No Fields 1 Square Feet 360 Linear Feet 120

No Lines 2 Trench Width 36" Trench Depth 36" Gravel Depth 12"

☐ New System ☑ Repair System Type: I, II, III, IV, V, VI

System Description: CONV. GRAVITY

Repair System Description:

Maintenance Agreement Required: ☐ Yes ☑ No

☐ House/Mod. Home No. Bedrooms 3 Garbage Disposal: ☐ Yes ☑ No

☐ Mobile Home No. Bathrooms 2 Auto. Dishwasher: ☑ Yes ☐ No


☐ Business No. Employees Auto. Washing Machine: ☑ Yes ☐ No

☐ Other Other


☐ Slab ☑ Crawl Space ☐ Basement w/plumbing ☐ Basement wo/plumbing

Comments NEW LINES INSTALLED 10' FROM POTENTIAL PROPERTY LINE FOR FUTURE DIVISION OF PROPERTY

INITIAL SITE SKETCH

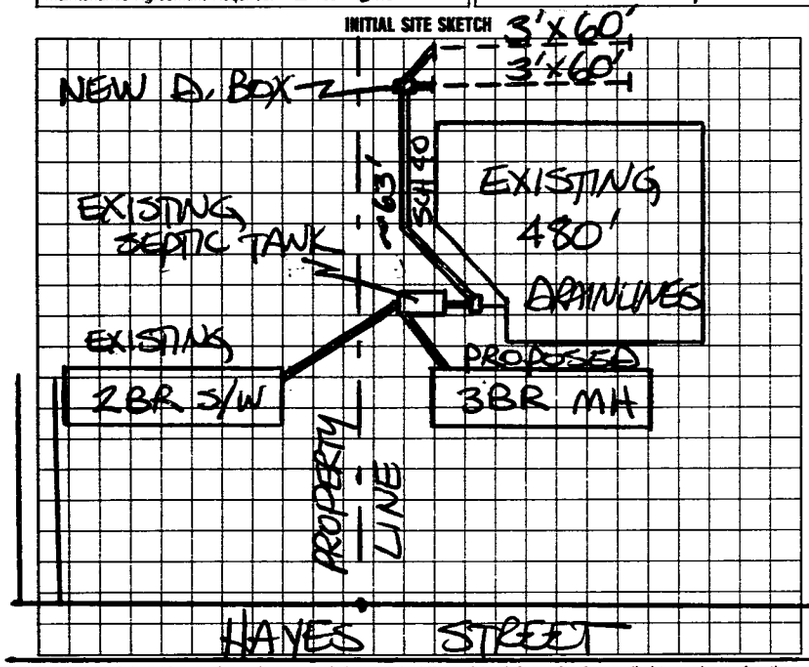

AS BUILT SKETCH

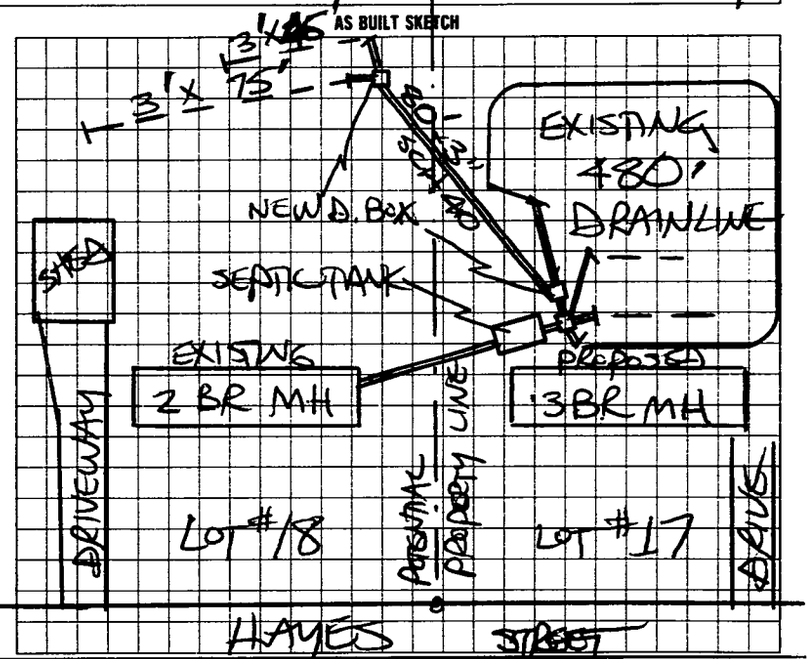

I understand that this permit can be suspended or revoked if any false information is supplied toward securing the permit/any unauthorized changes are made to the site/any unauthorized changes are made in the installation of the system. Improvement Permit is valid for 60 months from date of issuance.

Signed: X

Improvement Permit by: STEVE HEDRICK date 6/23/93

Existing System Inspection by: date

Installed by: TOMMY FRYE

Certificate of Completion by: STEVE HEDRICK date 7/2/93

Operation Permit by: date

HEALTH DEPT. COPY: WHITE INSPECTION COPY (FINAL): GREEN OWNER COPY (FINAL): YELLOW INSPECTION COPY (INITIAL): PINK OWNER COPY (INITIAL): GOLD