IREDELL COUNTY HEALTH DEPARTMENT

STATESVILLE 704-878-5305 MOORESVILLE 704-664-5281

IMPROVEMENT PERMIT / AUTHORIZATION TO CONSTRUCT / OPERATION PERMIT / EXISTING SYSTEM INSPECTION

PERMIT# 083802 PIN# 4871-71-7061 DATE 9-20-97

OWNER OR CONTRACTOR JERRY W. WILLIAMS PHONE: Business Home 546-2102

ADDRESS 202 HAYES STREET HARMONY, NC 28634

LOCATION US 21 N, TR HAYES STREET, MH ON RIGHT AT BOX #202

SUBDIVISION GARNER BLOCK / SECTION LOT 22 LOT AREA LIMITED SITE CLASS PS DESIGN FLOW 360 L.T.A.R. EXISTING

Septic Tank: 1000 Gallons; STB Date

Pump Tank: Gallons; PT Date

Pump Make: Model Serial No

Nitrification Field: No Fields 1 Square Feet Linear Feet ~240

No Lines THREE Trench Width Max Trench Bottom Depth Gravel Depth

~~New System~~ ☐ ~~Repair~~ System Type: ☐ I ☑ II ☐ III ☐ IV ☐ V ☐ VI

System Description: CONVENTIONAL GRAVITY

Repair System Description:

Maintenance Agreement Required: ☐ Yes ☑ No

☐ House/Mod. Home ☑ Mobile Home ☐ Business ☐ Other

No. Bedrooms 3 No. Bathrooms 2 No. Employees


☐ Slab ☑ Crawl Space ☐ Basement w/plumbing ☐ Basement wo/plumbing

Water Supply: ☐ Individual ☑ Public ☐ Community


Comments:/Conditions:

Comments:/Conditions ① SYSTEM UNDERSIZED ACCORDING TO TODAY'S STANDARDS ② KEEP MH MINIMUM FIVE FEET FROM SYSTEM

INITIAL SITE SKETCH

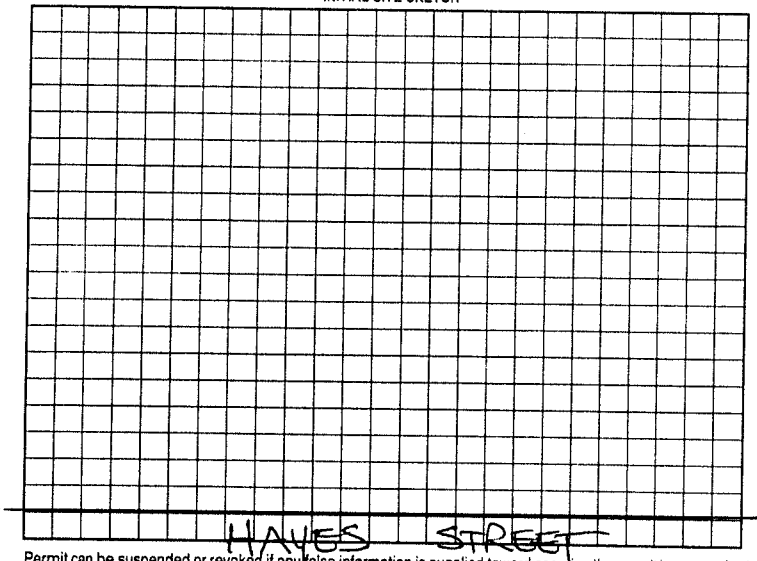

AS BUILT SKETCH

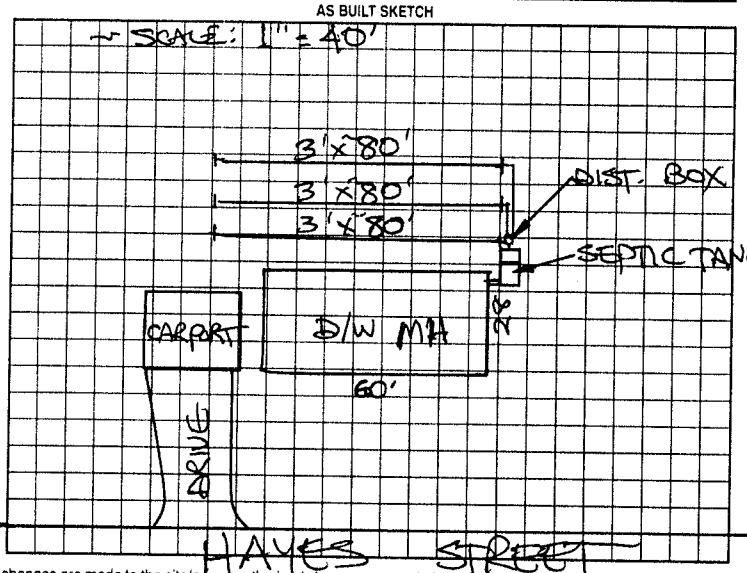

Permit can be suspended or revoked if any false information is supplied toward securing the permit/any unauthorized changes are made to the site/any unauthorized changes are made in the installation of the system. Improvement Permit with plat valid without expiration. Improvement Permit with site plan valid for sixty months. Authorization to Construct is valid for a period equal to that of Improvement Permit – not to exceed sixty months.

Signed: date

Improvement Permit by: date

Authorization to Construct by: date

Installed by:

Operation Permit by: date

Existing System Inspection by: STEVE HEDRICK date 9-20-99

HEALTH DEPT. COPY: WHITE OWNER COPY (FINAL) YELLOW OWNER COPY (INITIAL) PINK