IREDELL COUNTY HEALTH DEPARTMENT

STATESVILLE 704-878-5305 MOORESVILLE 704-664-5281

IMPROVEMENT PERMIT / AUTHORIZATION TO CONSTRUCT / OPERATION PERMIT / EXISTING SYSTEM INSPECTION

PERMIT# REPAIR PIN# 4871-73-1865 DATE 6-2-04

OWNER OR CONTRACTOR CHARLES C. TRIVETTE PHONE: Business Home 704-546-2554

ADDRESS 3693 HARMONY HWY, HARMONY, NC 28634-9439

LOCATION US 21 NORTH, 1.1 MILE ON LEFT PAST NC 901, BACK OFF ROAD.

SUBDIVISION BLOCK / SECTION LOT LOT AREA 18.18 ACRES SITE CLASS. PS DESIGN FLOW 360 L.T.A.R. EXISTING 0.30

Septic Tank: EXISTING Gallons: STB Date

Pump Tank: Gallons: PT Date

Pump Make: Model Serial No.

Nitrification Field: No Fields 1 Square Feet 450 Linear Feet 150

No Lines ONE Trench Width 36" Max Trench Bottom Depth 36" Gravel Depth 12"

☐ New System ☑ Repair System Type: I, (II), III, IV, V, VI

System Description:

Repair System Description: CONVENTIONAL, GRAVITY

Maintenance Agreement Required: ☐ Yes ☒ No

☑ House/Mod. Home No. Bedrooms 3

☐ Mobile Home No. Bathrooms 2

☐ Business No. Employees

☐ Other


☐ Slab ☑ Crawl Space ☐ Basement w/plumbing ☐ Basement wo/plumbing

Water Supply: ☐ Individual ☑ Public ☐ Community


Comments:/Conditions: (1) INTERCEPT OLD DRAINLINE WITH NEW DROP BOX AT LOCATION SHOWN FEEDING NEW 3'X150' LINE ON CONTOUR AS SHOWN. (2) THIS PERMIT SERVES AS "NOTICE OF VIOLATION" SYSTEM TO BE REPAIRED BY 7-2-04

Comments:/Conditions:

INITIAL SITE SKETCH

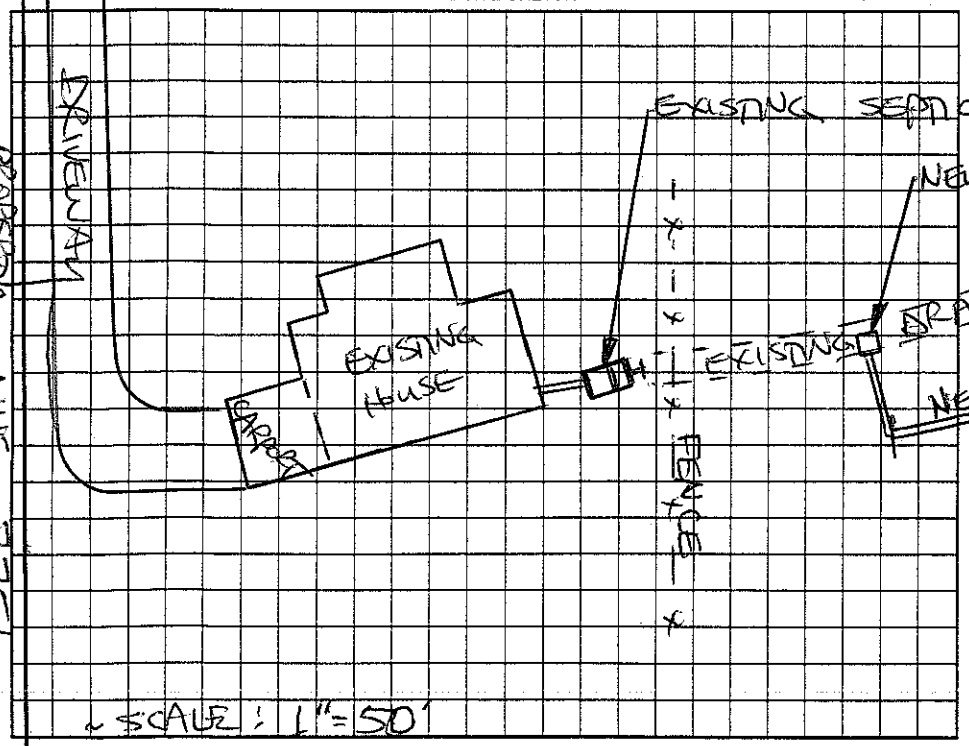

AS BUILT SKETCH

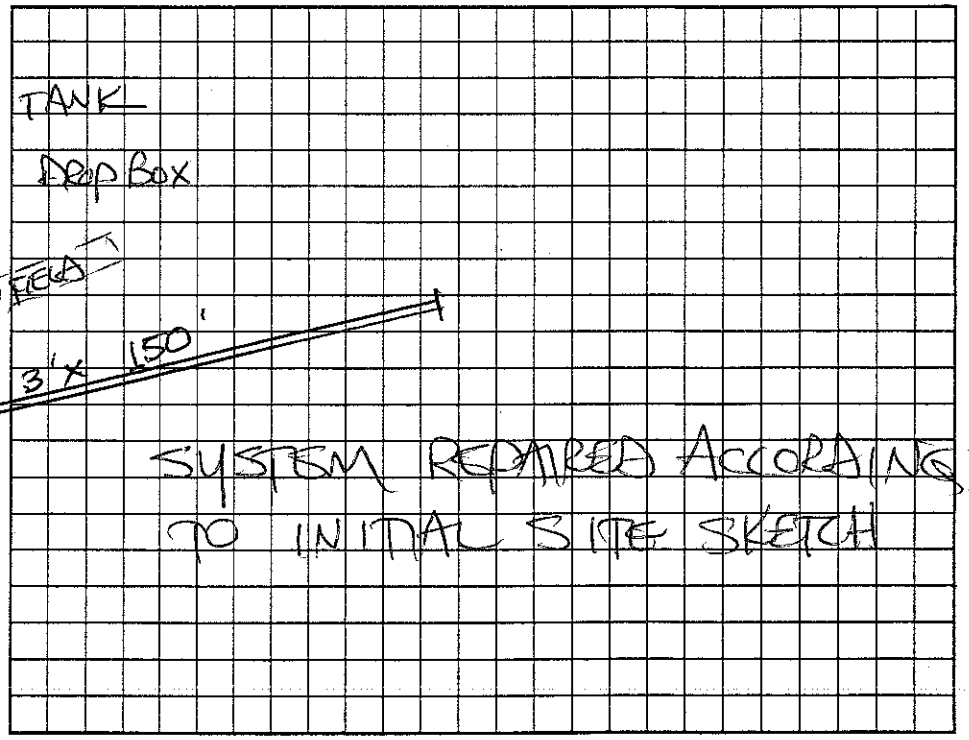

Permit can be suspended or revoked if any false information is supplied toward securing the permit/any unauthorized changes are made to the site/any unauthorized changes are made in the installation of the system. Improvement Permit with plat valid without expiration. Improvement Permit with site plan valid for sixty months. Authorization to Construct is valid for a period equal to that of Improvement Permit – not to exceed sixty months.

Signed: Charles C. Trivette date 6-2-04 Installed by: SAMMY REAVIS

Improvement Permit by: STEVE HEDRICK date 6-2-04 Operation Permit by: STEVE HEDRICK date 7-9-04

Authorization to Construct by: STEVE HEDRICK date 6-2-04 Existing System Inspection by: date

HEALTH DEPT. COPY: WHITE OWNER COPY (FINAL): YELLOW OWNER COPY (INITIAL): PINK