IREDELL COUNTY HEALTH DEPARTMENT

STATESVILLE 704-878-5305 MOORESVILLE 704-664-5281

IMPROVEMENT PERMIT / CERTIFICATE OF COMPLETION / OPERATION PERMIT / EXISTING SYSTEM INSPECTION

PROPERTY DESCRIPTION NO. REPAIR DATE 4/29/94 TAX MAP NO. REPAIR

OWNER OR CONTRACTOR CLYDE TRIVETTE

ADDRESS RT-2 Box 296, HARMONY, NC 28634 PHONE: Business 546-2554 Home 546-7478

LOCATION US 21 N, PAST HARMONY CITY LIMITS, 3RD HOUSE ON (L)

SUBDIVISION _____ BLOCK / SECTION _____ LOT _____ LOT AREA _____ SITE CLASS. PS DESIGN FLOW 360 L.T.A.R. _____

Watershed: ☐ Yes ☑ No

Septic Tank: EXISTING Gallons; STB _____ Date _____

Pump Tank: _____ Gallons; PT _____ Date _____

Pump Make: _____ Model _____ Serial No. _____

Nitrification Field: No Fields 1 Square Feet 900 Linear Feet 300

No Lines 5 Trench Width 36" Max Trench Bottom Depth 18-36 Gravel Depth 18-36

☐ New System ☑ Repair System Type: I II III, IV, V, VI

System Description: CONV. GRAVITY

Repair System Description: CONV. GRAVITY

Maintenance Agreement Required: ☐ Yes ☑ No

☑ House/Mod. Home No. Bedrooms 3

☐ Mobile Home No. Bathrooms 1

☐ Business No. Employees _____

☐ Other _____


☐ Slab ☑ Crawl Space ☐ Basement w/plumbing ☑ Basement wo/plumbing

Water Supply: ☑ Individual ☐ Community ☐ Public

Comments: KEEP 5' FROM PROPERTY LINE.

Comments: NEW "T" INSTALLED IN TANK

INITIAL SITE SKETCH

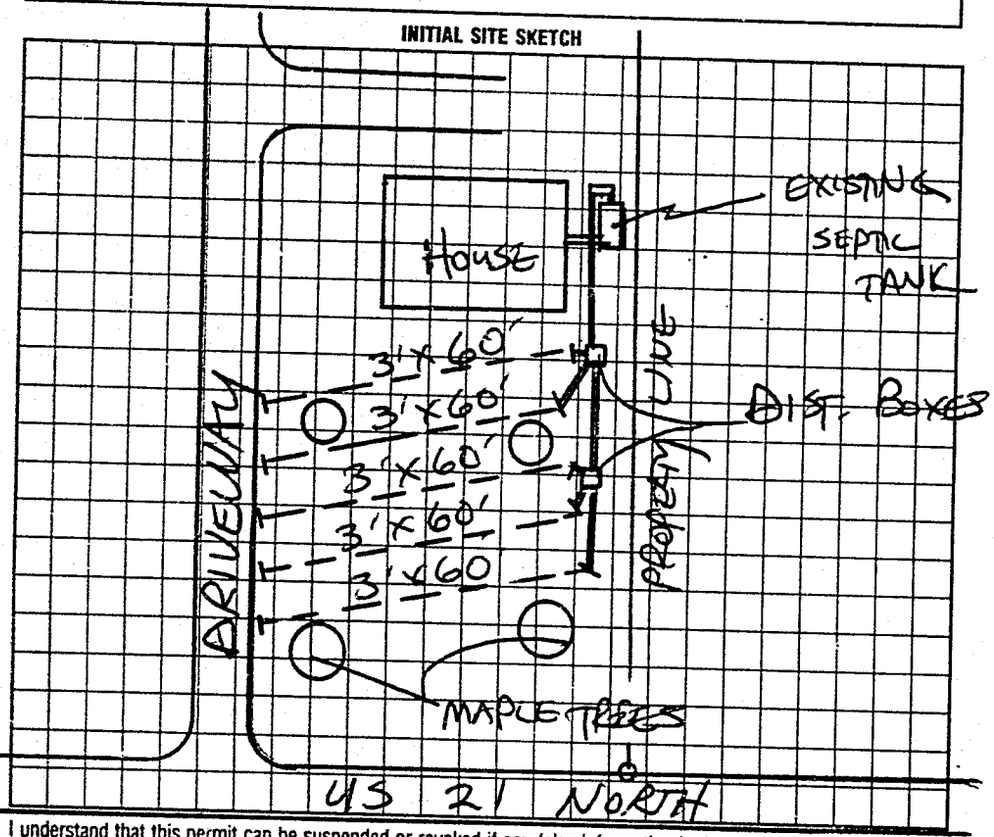

AS BUILT SKETCH

REPAIRED ACCORDING TO INITIAL SITE SKETCH

I understand that this permit can be suspended or revoked if any false information is supplied toward securing the permit/any unauthorized changes are made to the site/any unauthorized changes are made in the installation of the system. Improvement Permit is valid for 60 months from date of issuance.

Signed: X Clyde C. Trivette

Improvement Permit by: STEVE HEDRICK date 4/29/94

Existing System Inspection by: _____ date _____

Installed by: SAMMY REAVIS

Certificate of Completion by: STEVE HEDRICK date 5/26/94

Operation Permit by: _____ date _____

HEALTH DEPT. COPY: WHITE INSPECTION COPY (FINAL): GREEN OWNER COPY (FINAL): YELLOW INSPECTION COPY (INITIAL): PINK OWNER COPY (INITIAL): GOLD