IREDELL COUNTY HEALTH DEPARTMENT

STATESVILLE 704-878-5305 MOORESVILLE 704-664-5281

IMPROVEMENT PERMIT / CERTIFICATE OF COMPLETION / OPERATION PERMIT / EXISTING SYSTEM INSPECTION

PROPERTY DESCRIPTION NO. REPAIR DATE 4-30-97 TAX MAP NO. HARMONY Watershed: ☐ Yes ☐ No

OWNER OR CONTRACTOR BUDDY & DAVID GAITHER PHONE: Business 546-2523 Home

ADDRESS 3306 HARMONY HWY HARMONY NC 28634

LOCATION US 21 N, THIRD HOUSE ON LEFT BEFORE POWELL BRIDGE ROAD (AT #3653)

SUBDIVISION BLOCK / SECTION LOT LOT AREA LIMITED SITE CLASS. PS DESIGN FLOW 240 L.T.A.R. EXISTING

Septic Tank: EXISTING Gallons; STB Date

Pump Tank: Gallons; PT Date

Pump Make: Model Serial No.

Nitrification Field: No Fields 1 Square Feet 300 Linear Feet 100

No Lines THREE Trench Width 36" Max Trench Bottom Depth 36" Gravel Depth 24"

☐ New System ☒ Repair System Type: I, II, III, IV, V, VI

System Description: CONV. GRAVITY

Repair System Description: CONV. GRAVITY

Maintenance Agreement Required: ☐ Yes ☒ No

☒ House/Mod. Home No. Bedrooms 2

☐ Mobile Home No. Bathrooms 1

☐ Business No. Employees

☐ Other


☐ Slab ☒ Crawl Space ☐ Basement w/plumbing ☐ Basement wo/plumbing

Water Supply: ☐ Individual ☐ Community ☒ Public


Comments: ① PUMP-OUT EXISTING SEPTIC TANK, REPLACE SANITARY TEE IF NECESSARY ② INSTALL NEW LINES AS SHOWN 10' FROM WATER LINE, 5' FROM PROPERTY LINE, 24" STONE ③ SYSTEM TO BE REPAIRED BY 5-31-97

Comments: * Keep Water line 10ft !! from system

INITIAL SITE SKETCH

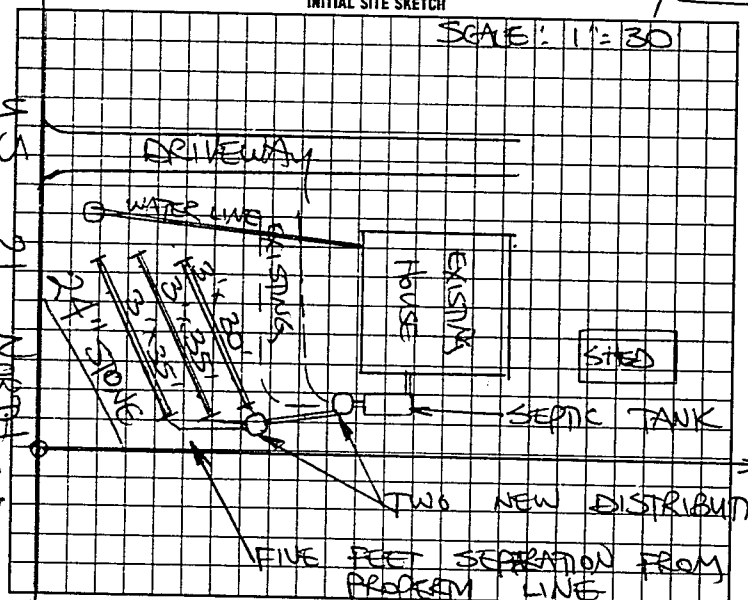

AS BUILT SKETCH

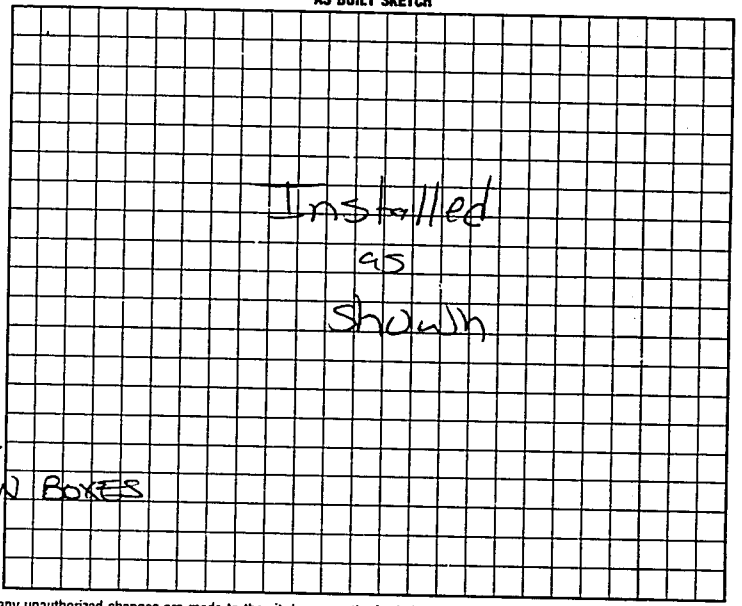

I understand that this permit can be suspended or revoked if any false information is supplied toward securing the permit/any unauthorized changes are made to the site/any unauthorized changes are made in the installation of the system. Improvement Permit is valid for 60 months from date of issuance. IMPR. TO CONST. IS VALID FOR 60 MONTHS FROM DATE OF ISSUANCE

Signed: David Shelton

Improvement Permit by: STEVE HEDRICK date 4-30-97

IMPR. TO CONST. Existing System Inspection by: STEVE HEDRICK date 4-30-97

Installed by: Tommy Fite

Certificate of Completion by:

Operation Permit by: Mat Coty IS date 7-22-97

HEALTH DEPT. COPY: WHITE INSPECTION COPY (FINAL): GREEN OWNER COPY (FINAL): YELLOW INSPECTION COPY (INITIAL): PINK OWNER COPY (INITIAL): GOLD