2:00

IREDELL COUNTY HEALTH DEPARTMENT - *ENVIRONMENTAL HEALTH* ☑ STATESVILLE OFFICE 704-878-5305 ☐ MOORESVILLE OFFICE 704-664-5281

IMPROVEMENT PERMIT / AUTHORIZATION TO CONSTRUCT / OPERATION PERMIT / EXISTING SYSTEM INSPECTION

PERMIT # 164642 PIN # 4871-18-8205 DATE 19 January 2011

OWNER Thomas Mount APPLICANT: PHONE: Home/Cell # (814) 323-1158 Business #

SITE ADDRESS 331 Butler Mill Rd. Harmony OWNER / APPLICANT ADDRESS

SITE DIRECTIONS Hwy 21 N TR Tomlinson Rd. Change to Butler Mill - 3rd House on left after name change.

SUBDIVISION BLOCK / SECTION LOT # LOT AREA 13 Ac. DESIGN FLOW 360 gpd L.T.A.R. 0.3 g/ft²/d

Septic Tank 1000 Gallons: STB 160 Date 9-10-10 ☑ New System ☐ Repair ☐ Expansion System Type I II III IV V VI

Pump Tank Gallons: P T Date System Description: 25% Reduction

Pump Make Model Serial # Repair System Description: 25% Reduction

No. Nitrification Fields: 1 No. Lines 3 Linear Feet 300 Maintenance Agreement Required ☐ YES ☑ NO


Trench Width 36" Max. Trench Bottom Depth 36" Gravel Depth NA ☑ GRAVITY ☐ PRESSURE

☑ Residence No. Bedrooms 3 ☐ Business No. Persons ☐ Other No. Employees ☐ Slab ☐ Crawl Space ☐ Basement w/plumbing ☑ Basement w/o plumbing


Water Supply: ☐ Private ☑ Public ☐ Community

Comments / Conditions

INITIAL SITE SKETCH

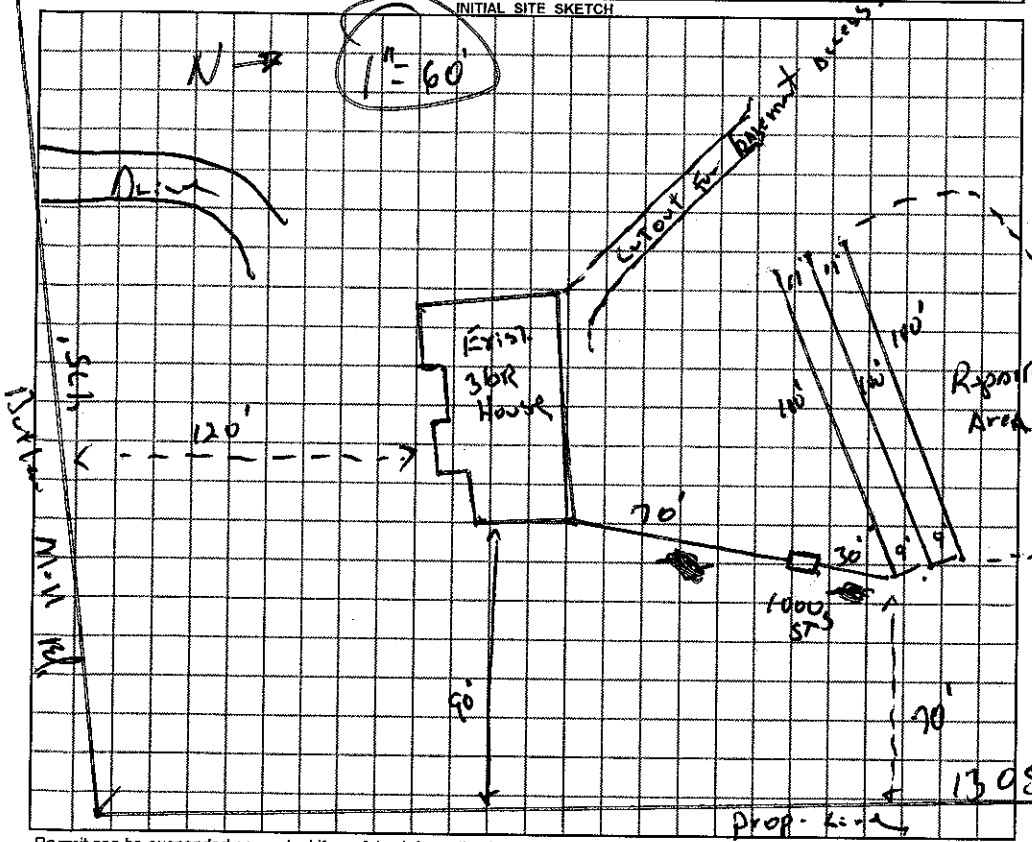

AS BUILT SKETCH

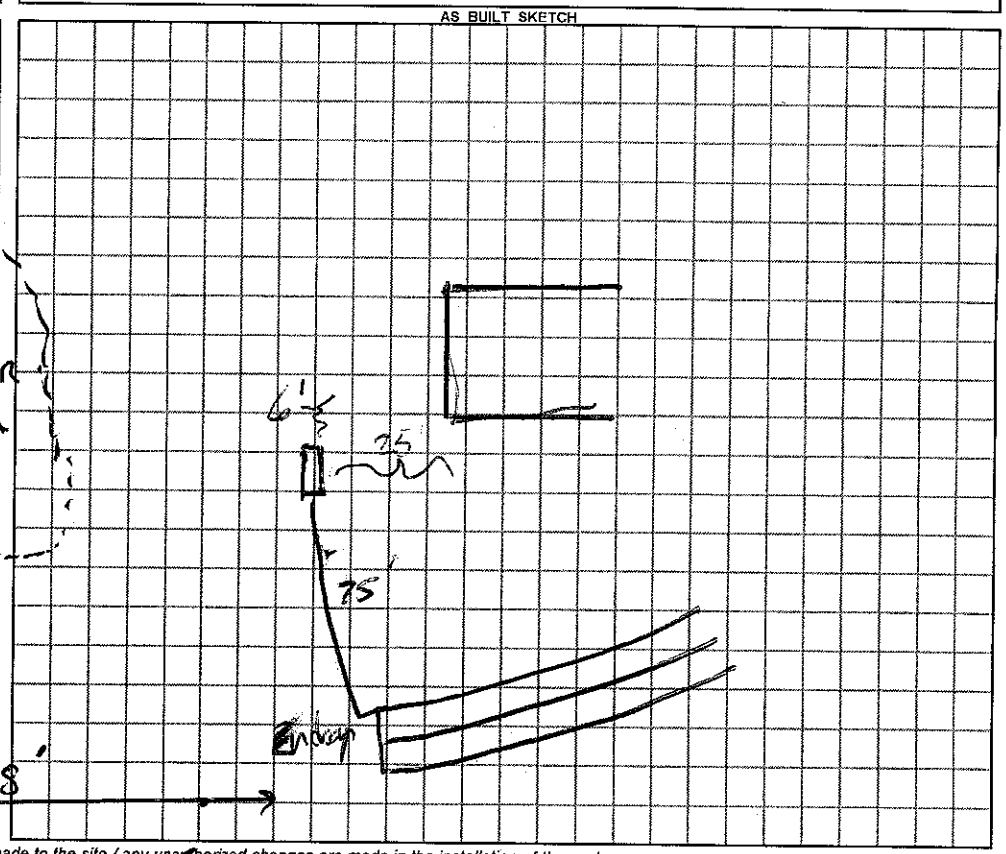

Permit can be suspended or revoked if any false information is supplied toward securing the permit / any unauthorized changes are made to the site / any unauthorized changes are made in the installation of the system.

☑ ***IMPROVEMENT PERMIT*** with plat valid without expiration ☑ ***IMPROVEMENT PERMIT*** with plat valid ~~without expiration~~ 60 mos. ☑ ***AUTHORIZATION TO CONSTRUCT*** valid for period equal to IMPROVEMENT PERMIT–not to exceed 60 mo.

Owner / Applicant Signature: Date 1/21/11 Installed by: Barnes Grading

IMPROVEMENT PERMIT by: REHS Date 19 Jan 11 OPERATION PERMIT by: REHS Date 2-1-11

AUTHORIZATION TO CONSTRUCT by: REHS Date 19 Jan 11 Existing System Inspected by: REHS Date

YOU SHOULD CONTACT A LOCATOR SERVICE PRIOR TO ANY EXCAVATION

White Copy – Environmental Health YELLOW COPY (Final) Owner / Applicant PINK COPY (Initial) Owner / Applicant