IREDELL COUNTY HEALTH DEPARTMENT

Statesville Office (704) 878-5305 Mooresville Office (704) 660-3625 PERMIT # 207139

IMPROVEMENT PERMIT / AUTHORIZATION TO CONSTRUCT / OPERATION PERMIT / EXISTING SYSTEM

PIN # 4871885838 5851

APPLICANT: John Mayberry APPLICANT ADDRESS: 105 Mayberry Rd.

SITE ADDRESS: 105 Mayberry Rd. PHONE: 704-546-2483 ALT. PHONE: N/A 214923

SITE DIRECTIONS: Hwy 21 N TR Mayberry Rd. Property 1st house on Left


SUBDIVISION: N/A SECTION: N/A LOT # N/A LOT AREA: 2.781 acres DESIGN FLOW: 360 gpd L.T.A.R.: 0.25

Septic Tank	1000	(gal)	STB	760-1000	Date	8-1	☐ New System	☑ Repair	☐ Expansion	System Type: I II (III) IV V VI	☑ Residence	No. Bedrooms	3	Water Supply			
Pump Tank	1000	(gal)	PT	363-1000	Date	11-21	System Description:	25% Reduction			☐ Business	No. Persons	6	☑ Private			
Pump Make	Zoeller	Model	N62N		Serial #		Repair System Description:				☐ Other	No. Employees		☐ Public			
# Nitrification Fields	1	# Lines	3		Linear Ft:	330	Maintenance Agreement Required:	☐ YES	☑ NO		☐ Slab	☐ Crawl Space		☐ Community			
Trench Width	36"	Max. Trench Bottom Depth	33"		Gravel Depth	N/A		☐ GRAVITY	☑ PRESSURE		☑ Basement w/plumbing			☐ Basement w/o plumbing			


Comments / Conditions: Record New Property lines prior to issuance of CA! Pump & crush existing septic tank. Install a 25% Reduction system on Contour with parallel distribution.

- Refer to attached pump design specs.

INITIAL SITE SKETCH

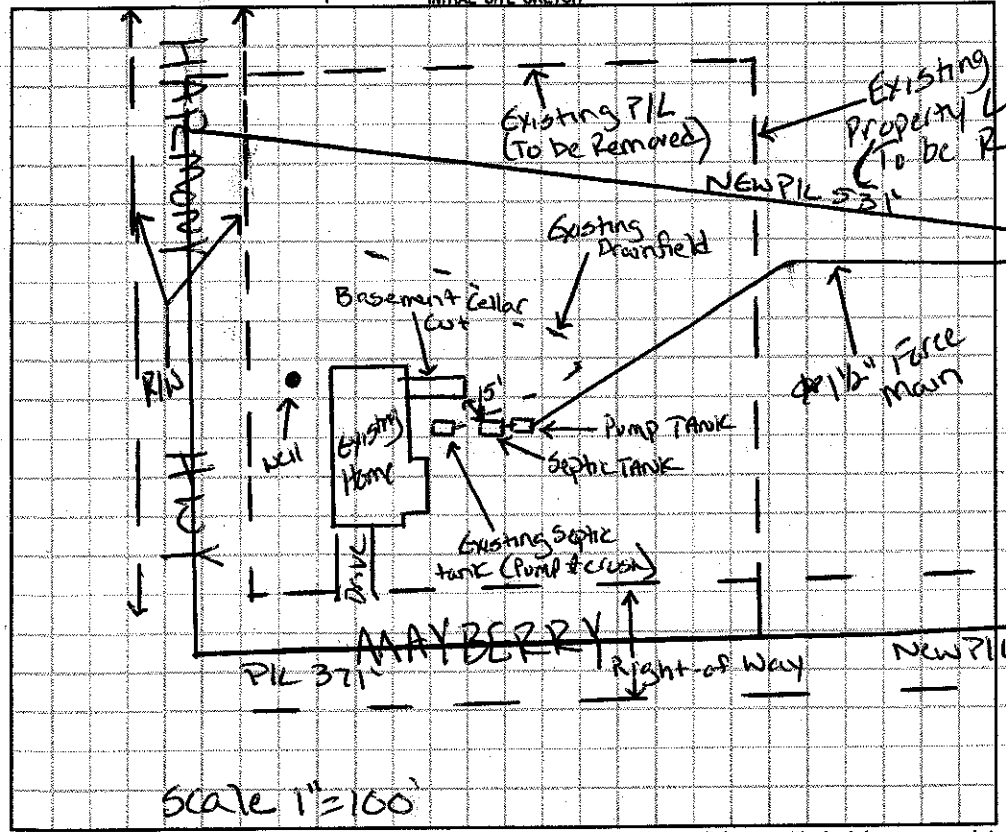

AS BUILT SKETCH

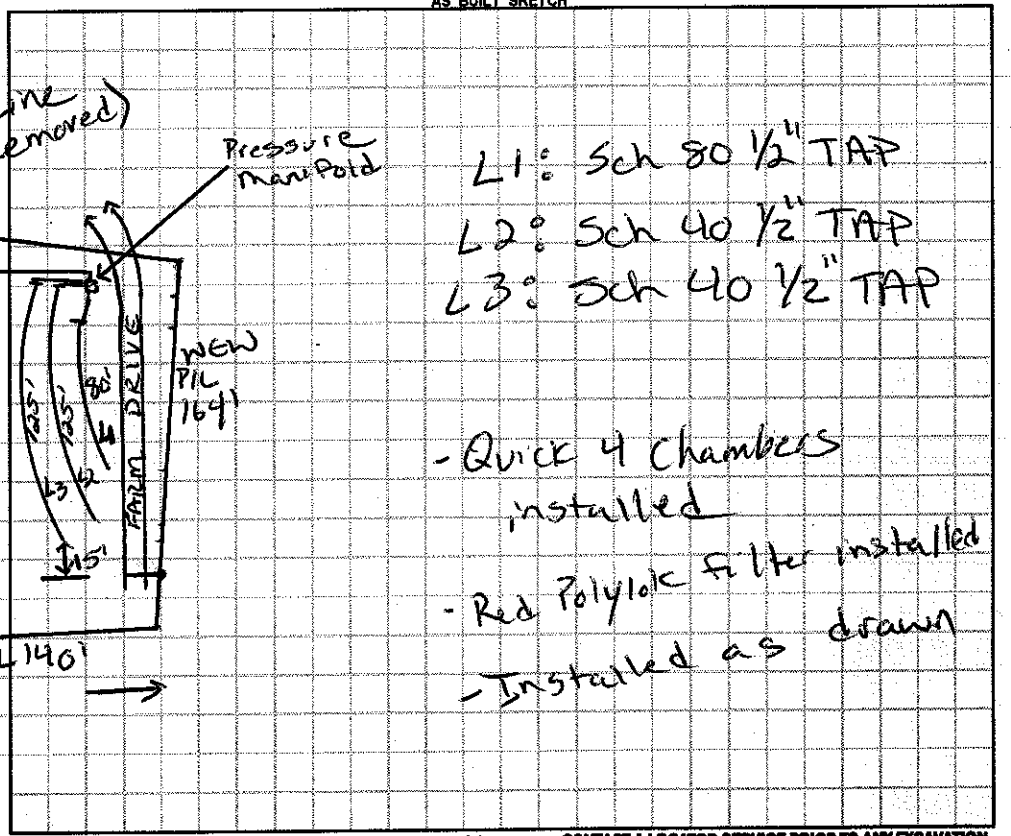

Permit can be suspended or revoked if any false information is supplied toward securing the permit / any unauthorized changes are made to the site / any unauthorized changes are made in the installation of the system. **CONTACT A LOCATOR SERVICE PRIOR TO ANY EXCAVATION**

☐ **IMPROVEMENT PERMIT** *with plat valid without expiration.* ☑ **IMPROVEMENT PERMIT** *with site plan valid for 60 mos.* ☐ **AUTHORIZATION TO CONSTRUCT** *valid for period equal to IMPROVEMENT PERMIT--not to exceed 60 mo.*

Owner / Applicant Signature: John Mayberry Date: Installed by: Sammy Reaves

IMPROVEMENT PERMIT by: Justin Henderson Date: 12-7-15 OPERATION PERMIT by: Justin Henderson Date: 2-22-16

AUTHORIZATION TO CONSTRUCT by: Justin Henderson Date: 12-8-15 Existing System Inspected by: Date:

Health Dept. Copy - WHITE Applicant (Final Approval) - YELLOW Applicant (Conditional Approval) - PINK