IREDELL COUNTY HEALTH DEPARTMENT

STATESVILLE 704-878-5305 (C1) MOORESVILLE 704-664-5281

IMPROVEMENT PERMIT / AUTHORIZATION TO CONSTRUCT / OPERATION PERMIT / EXISTING SYSTEM INSPECTION

PERMIT# 108576 PIN# 4871-94-2927. A DATE 9-16-02

OWNER OR CONTRACTOR JOYCE HOLAND PHONE: Business Home 704-546-2968

ADDRESS 165 POWELL BRIDGE RD, HARMONY NC 28634

LOCATION US 21 N, TR POWELL BRIDGE RD, D/W/MH' BACK OFF ROAD AT BOX # 167

SUBDIVISION BLOCK / SECTION LOT LOT AREA 1.00 ACRE SITE CLASS PS DESIGN FLOW 360 L.T.A.R. 0.30 GPD/FT²

Septic Tank: EXISTING Gallons: STB 1 Date

Pump Tank: Gallons; PT Date

Pump Make: Model Serial No.

Nitrification Field: No Fields 1 Square Feet 480 Linear Feet 160

No Lines TWO (2) Trench Width 36" Max Trench Bottom Depth 36" Gravel Depth 12"

☑ New System ☐ Repair System Type: I (II) III IV V VI

System Description: CONVENTIONAL GRAVITY

Repair System Description: CONVENTIONAL GRAVITY

Maintenance Agreement Required: ☐ Yes ☑ No

☐ House/Mod. Home ☑ Mobile Home ☐ Business ☐ Other

No. Bedrooms 3 No. Bathrooms 2 No. Employees


☐ Slab ☑ Crawl Space ☐ Basement w/plumbing ☐ Basement wo/plumbing

Water Supply: ☐ Individual ☐ Public ☐ Community

Comments/Conditions: EXPAND SYSTEM BY ADDING 3 DROP BOXES AND TWO NEW 3'x 80' DRAWLINES


Comments/Conditions

INITIAL SITE SKETCH

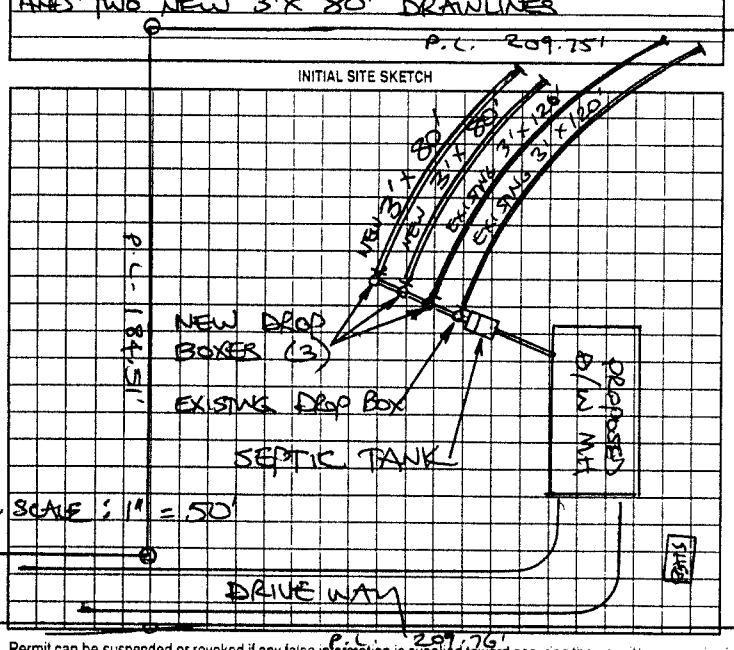

SCALE: 1" = 50'

AS BUILT SKETCH

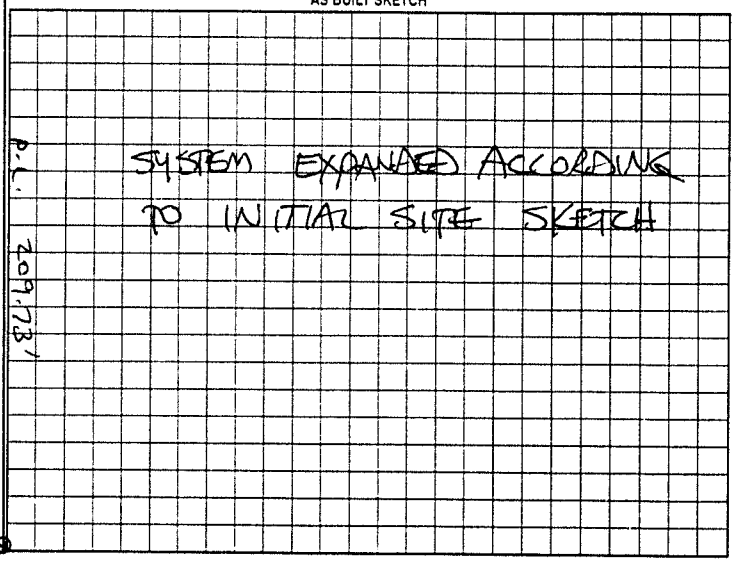

Permit can be suspended or revoked if any false information is supplied toward securing the permit; any unauthorized changes are made to the site; any unauthorized changes are made in the installation of the system. Improvement Permit with plat valid without expiration. Improvement Permit with site plan valid for sixty months. Authorization to Construct is valid for a period equal to that of Improvement Permit – not to exceed sixty months

Signed: Joyce Holand date 9-16-02 Installed by A-1 BACKHOE

Improvement Permit by: STEVE HEDRICK date 9-16-02 Operation Permit by: STEVE HEDRICK date 9-20-02

Authorization to Construct by: STEVE HEDRICK date 9-16-02 Existing System Inspection by: date

HEALTH DEPT. COPY: WHITE OWNER COPY (FINAL): YELLOW OWNER COPY (INITIAL): PINK