IREDELL COUNTY HEALTH DEPARTMENT

STATESVILLE 704-878-5305 MOORESVILLE 704-664-5281

IMPROVEMENT PERMIT / AUTHORIZATION TO CONSTRUCT / OPERATION PERMIT / EXISTING SYSTEM INSPECTION

PERMIT# REPAIR PIN#

DATE 12-30-98

OWNER OR CONTRACTOR WALTER JOHNSON PHONE: Business Home 539-5531

ADDRESS 430 W. HOUSTONVILLE ROAD HARMONY, NC 28634

LOCATION US 21 NORTH, TL W. HOUSTONVILLE RD HOUSE ON RIGHT AT TROY MILL ROAD

SUBDIVISION BLOCK / SECTION LOT LOT AREA 2 ACRE SITE CLASS. 5 DESIGN FLOW 240 L.T.A.R. EXISTING

Septic Tank: 1000 Gallons; STB 1012 Date 10-10-98

Pump Tank: Gallons; PT Date

Pump Make: Model Serial No.

Nitrification Field: No Fields 1 Square Feet Linear Feet EXISTING

No Lines Trench Width Max Trench Bottom Depth Gravel Depth

☐ New System ☑ Repair System Type: I, II, III, IV, V, VI

System Description:

Repair System Description: CONV. GRAVITY

Maintenance Agreement Required: ☐ Yes ☐ No

☑ House/Mod. Home No. Bedrooms 1

☐ Mobile Home No. Bathrooms 1

☐ Business No. Employees

☐ Other


☐ Slab ☑ Crawl Space ☐ Basement w/plumbing ☐ Basement wo/plumbing

Water Supply: ☑ Individual ☐ Public ☐ Community

Comments:/Conditions: ~~TANK PERMIT~~

Comments:/Conditions:

INITIAL SITE SKETCH

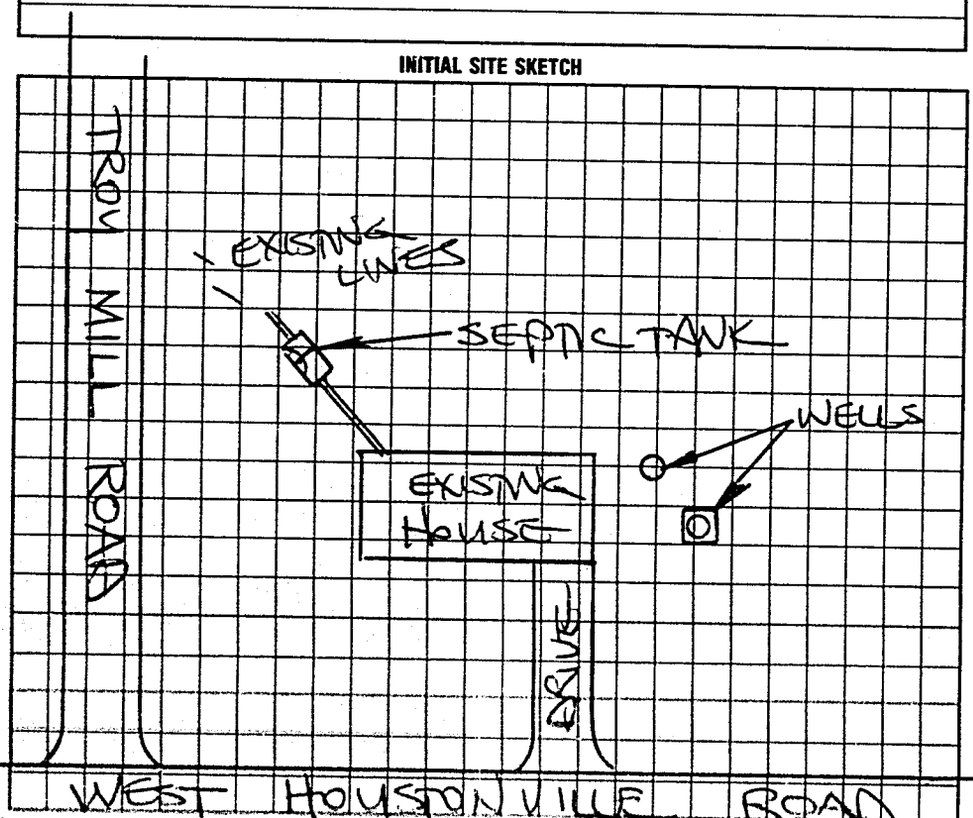

AS BUILT SKETCH

I understand that this permit can be suspended or revoked if any false information is supplied toward securing the permit/any unauthorized changes are made to the site/any unauthorized changes are made in the installation of the system. Improvement Permit with plat valid without expiration. Improvement Permit with site plan valid for sixty months. Authorization to Construct is valid for a period equal to that of Improvement Permit – not to exceed sixty months.

Signed: +Walter by Johnson date 12-30-98 Installed by: SAMMY REAVIS

Improvement Permit by: STEVE HEDRICK date 12-30-98 Operation Permit by: STEVE HEDRICK date 12-30-98

Authorization to Construct by: STEVE HEDRICK date 12-30-98 Existing System Inspection by: date

HEALTH DEPT. COPY: WHITE INSPECTION COPY (FINAL): GREEN OWNER COPY (FINAL): YELLOW INSPECTION COPY (INITIAL): PINK OWNER COPY (INITIAL): GOLD

022200