IREDELL COUNTY HEALTH DEPARTMENT

THIS PERMIT VOIDS PREVIOUS ISSUED 1-26-01

STATESVILLE 704-878-5305 MOORESVILLE 704-664-5281

IMPROVEMENT PERMIT / AUTHORIZATION TO CONSTRUCT / OPERATION PERMIT / EXISTING SYSTEM INSPECTION

PERMIT# 093835 PIN# 4872-10-1592 DATE 7-16-01

OWNER OR CONTRACTOR ANDREW J. ALLEN PHONE: Business (704) 546-7974 Home

ADDRESS 587 RABBIT Highway, HARMONY, NC. 28634

LOCATION US 21 N, TL LITTLE WILKESBORO, TR RABBIT Hwy, TL KIMMON ROAD, AT CORNER ON RIGHT

SUBDIVISION BLOCK / SECTION LOT LOT AREA 7.95 ACRES SITE CLASS PS DESIGN FLOW 360 L.T.A.R. 0.30 GPD/FT²

Septic Tank: 1000 Gallons: STB 160 Date 5-8-01

Pump Tank: Gallons: PT Date

Pump Make: Model Serial No.

Nitrification Field: No Fields 1 Square Feet 600 to 1200 Linear Feet 300 ft

No Lines THREE Trench Width 36" Max Trench Bottom Depth 36" Gravel Depth N/A

~~New System~~ ☐ Repair System Type: I, II, (III), IV, V, VI

System Description: 25% REDUCTION GRAVITY

Repair System Description: 25% REDUCTION ~~GRAVITY~~ PUMP

Maintenance Agreement Required: ☐ Yes ☑ No

☐ Slab ☑ Crawl Space ☐ Basement w/plumbing ☐ Basement wo/plumbing

~~House~~/Mod. Home ☐ Mobile Home ☐ Business ☐ Other


No. Bedrooms 3 No. Bathrooms 2 No. Employees

Water Supply: ☑ Individual ☐ Public ☐ Community WELL

Comments/Conditions: INSTALL 25% REDUCTION SYSTEM USING 50 CHAMBERS OR 30 HAS SECTIONS

Comments/Conditions SEPTIC TANK WITH MARKER INSTALLED USING "ZABEL" FILTER

INITIAL SITE SKETCH

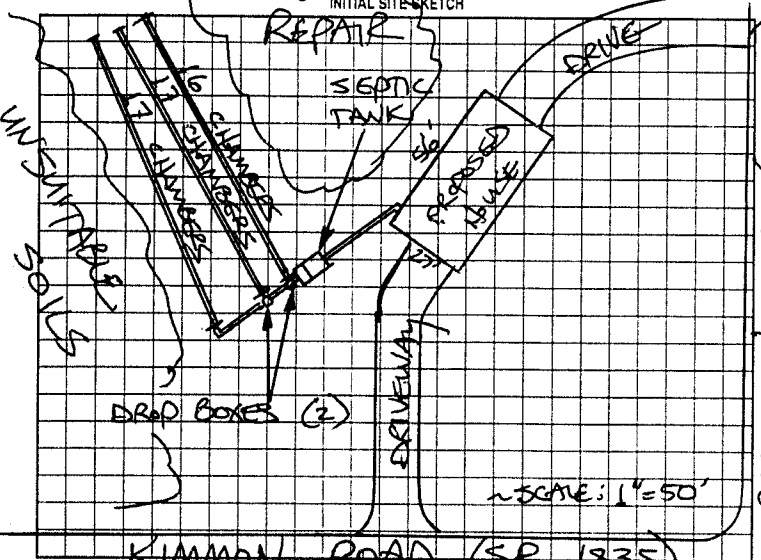

AS BUILT SKETCH

SYSTEM INSTALLED ACCORDING TO INITAL SITE SKETCH

Permit can be suspended or revoked if any false information is supplied toward securing the permit any unauthorized changes are made to the site any unauthorized changes are made in the installation of the system. Improvement Permit with plat valid without expiration. Improvement Permit with site plan valid for sixty months. Authorization to Construct is valid for a period equal to that of Improvement Permit – not to exceed sixty months.

Signed: Andrew J Allen date 7/16/01 Installed by: DAVID UMBARGER

Improvement Permit by: STEVE HEDRICK date 7-16-01 Operation Permit by: STEVE HEDRICK date 8-2-01

Authorization to Construct by: STEVE HEDRICK date 7-16-01 Existing System Inspection by: date

HEALTH DEPT. COPY WHITE OWNER COPY (FINAL) YELLOW OWNER COPY (INITIAL) PINK