* PERMIT REPLACES ONE ISSUED 11-4-03, NOW VOID

IREDELL COUNTY HEALTH DEPARTMENT

STATESVILLE 704-878-5305 (1) MOORESVILLE 704-664-5281

IMPROVEMENT PERMIT / AUTHORIZATION TO CONSTRUCT / OPERATION PERMIT / EXISTING SYSTEM INSPECTION

PERMIT# 116615 PIN# 4872-15-5878 944 DATE 4-22-05

OWNER OR CONTRACTOR ROBERT G. HOCKENBERRY PHONE: Business (704) 546-2861 Home

ADDRESS 136 HAYSTACK LN. OLIN, NC 28660

LOCATION I-77 N TO EXIT 65 TR HWY 901 TL EAGLE MILLS RD. TR HOUSTONVILLE TL TROY MILL TL YORKSPANN 1ST HSE ON RT.

SUBDIVISION Hockenberry Properties SECTION LOT 2 LOT AREA 4.2 SITE CLASS. PS DESIGN FLOW 360 L.T.A.R. 0.30 gpd/ft²

Septic Tank: 1000 Gallons; STB 160 Date 3-6-05

Pump Tank: Gallons; PT Date

Pump Make: Model Serial No.

Nitrification Field: No Fields 1 Square Feet 1200 Linear Feet 300

No Lines 4 Trench Width 36" Max Trench Bottom Depth 36" Gravel Depth N/A

☑ New System ☐ Repair System Type: I, II, (III) IV, V, VI

System Description: GRAVITY 25% REDUCTION

Repair System Description: PUMP 25% REDUCTION

Maintenance Agreement Required: ☐ Yes ☑ No

☑ House/Mod. Home No. Bedrooms 3

☐ Mobile Home No. Bathrooms

☐ Business No. Employees

☐ Other


☐ Slab ☑ Crawl Space ☐ Basement w/plumbing ☐ Basement wo/plumbing

Water Supply: ☑ Individual ☐ Public ☐ Community


Comments/Conditions: (1) INSTALL LINES ON CONTOUR (2) MAINTAIN SETBACKS (3) KEEP WELL 100' FROM SYSTEM

Comments/Conditions: SEPTIC TANK WITH MARKER INSTALLED USING "ZABEL" FILTER

INITIAL SITE SKETCH

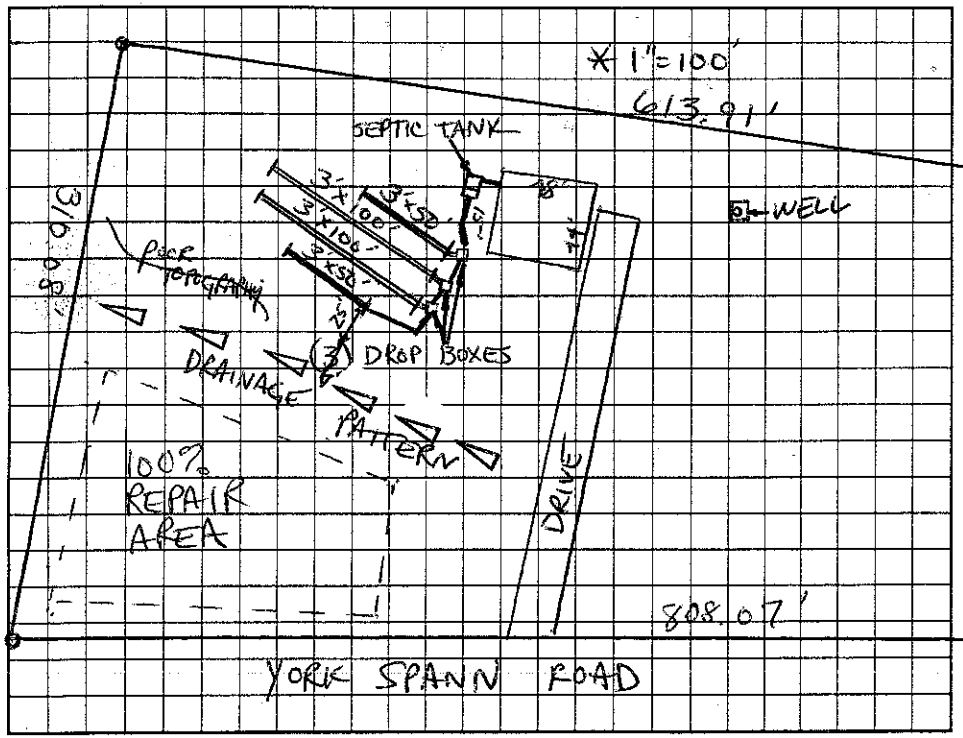

AS BUILT SKETCH

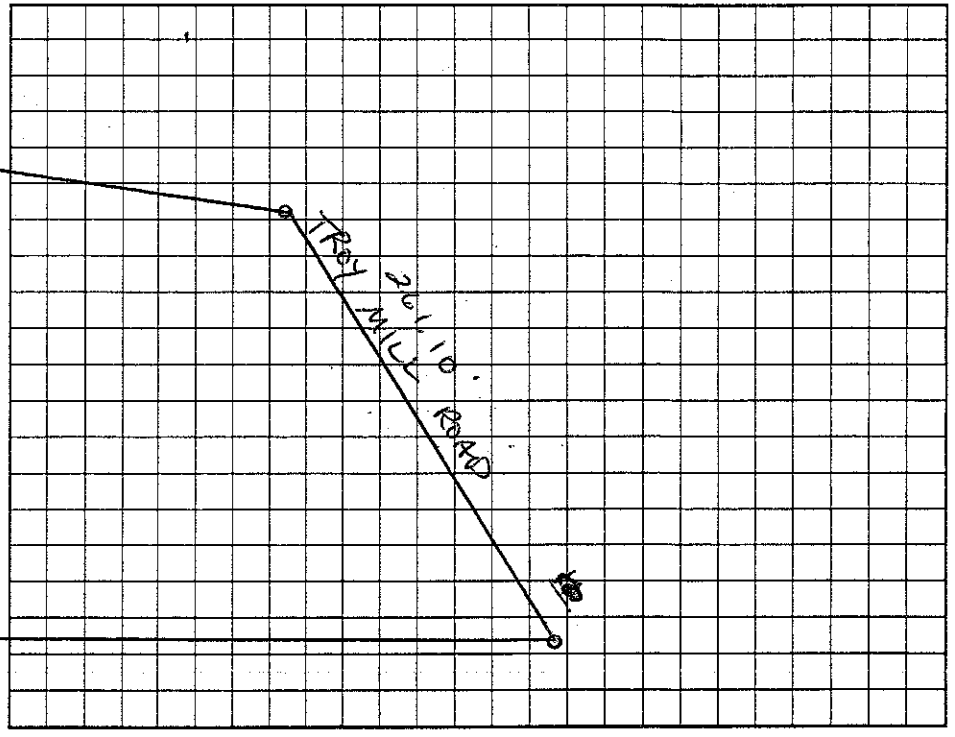

Permit can be suspended or revoked if any false information is supplied toward securing the permit/any unauthorized changes are made to the site/any unauthorized changes are made in the installation of the system. Improvement Permit with plat valid without expiration. Improvement Permit with site plan valid for sixty months. Authorization to Construct is valid for a period equal to that of Improvement Permit – not to exceed sixty months.

Signed: date

Improvement Permit by: LSS date 4-22-05

Authorization to Construct by: LSS date 4-22-05

Installed by: DAVID UMBARGER

Operation Permit by: STEVE HEDRICK date 5-26-05

Existing System Inspection by: date

HEALTH DEPT. COPY: WHITE OWNER COPY (FINAL): YELLOW OWNER COPY (INITIAL): PINK