IREDELL COUNTY HEALTH DEPARTMENT

STATESVILLE 704-878-5305 (c1) MOORESVILLE 704-664-5281

IMPROVEMENT PERMIT / AUTHORIZATION TO CONSTRUCT / OPERATION PERMIT / EXISTING SYSTEM INSPECTION

(c) (R)

PERMIT# 144654 PIN# 4872-17-~~5364~~ (69959 DATE 8-27-07

OWNER OR APPLICANT ROBERT & KAREN GOCHNAUER PHONE: Business 704-516-5454 Home 704 892-1998

ADDRESS 16715 DAVIDSON CONCORD ROAD, DAVIDSON, NC 28036

LOCATION EAGLE MILL ROAD to N. HOUSTONVILLE ROAD, TL TROY MILLER RD TL YORK SPANN ROAD ~ 0.3 MILE on R

SUBDIVISION _____ BLOCK / SECTION _____ LOT _____ LOT AREA 13.71 ACRES SITE CLASS. PS DESIGN FLOW 100 L.T.A.R. 0.30 GPD/FT²

Septic Tank: 1000 Gallons; STB 160 Date 5-19-08

Pump Tank: _____ Gallons; PT _____ Date _____

Pump Make: _____ Model _____ Serial No. _____

Nitrification Field: No Fields 1 Square Feet 333 Linear Feet 111

No Lines ONE Trench Width 36" Max Trench Bottom Depth 30"

☑ New System ☐ Repair ☐ Expansion System Type: I II III IV V VI

System Description: CONVENTIONAL GRAVITY

Repair System Description: CONVENTIONAL GRAVITY

Maintenance Agreement Required: ☐ Yes ☑ No

Gravel Depth 12" ☑ Gravity ☐ Pressure

☐ House/Mod. Home No. Bedrooms ____

☐ Mobile Home No. Persons ____

☐ Business No. Employees 4

☑ Other BARN W/4 PERSONS


☑ Slab ☐ Crawl Space ☐ Basement w/plumbing ☐ Basement wo/plumbing

Water Supply: ☑ Individual ☐ Public ☐ Community WELL


Comments/Conditions: ① AN "ACCEPTA" SYSTEM MAY ALSO BE USED, ② KEEP SYSTEM MINIMUM 100 FEET FROM WELL.

Comments/Conditions: Septic Tank with marker installed using red "polylok" filter

INITIAL SITE SKETCH

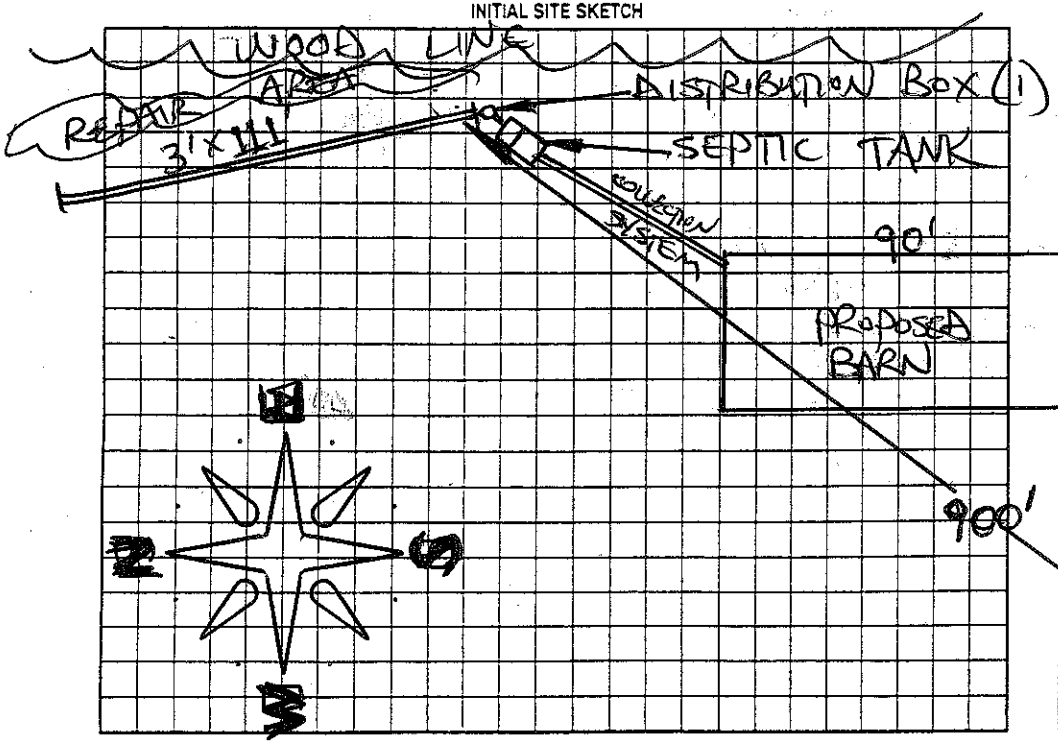

AS BUILT SKETCH

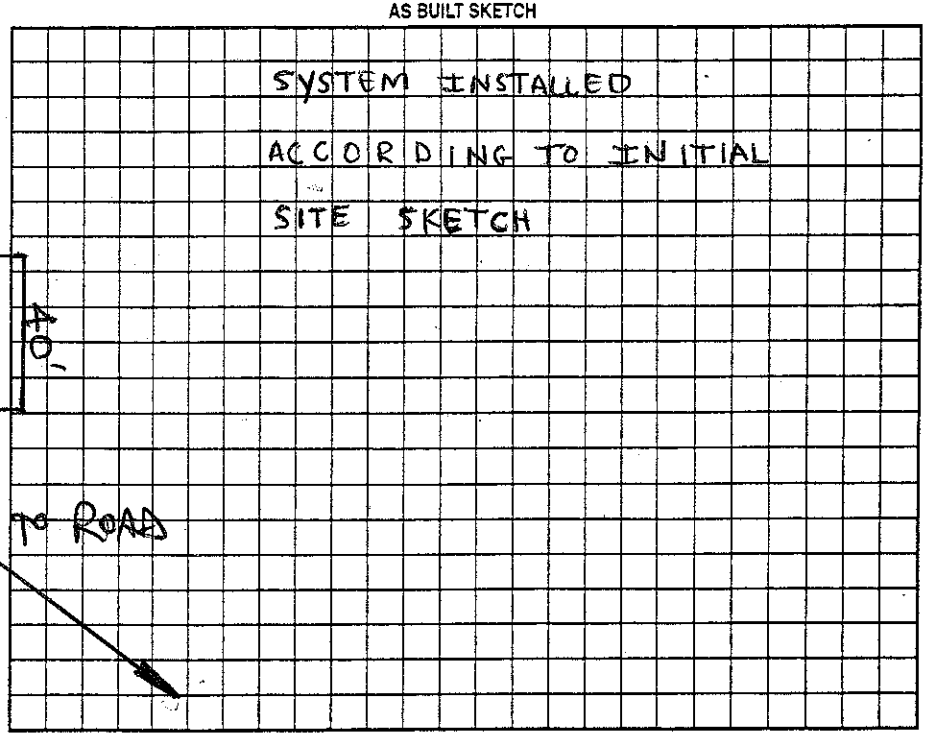

Permit can be suspended or revoked if any false information is supplied toward securing the permit/any unauthorized changes are made to the site/any unauthorized changes are made in the installation of the system. Improvement Permit with plat valid without expiration ☐ Improvement Permit with site plan valid for sixty months ☑ Authorization to Construct is valid for a period equal to that of Improvement Permit – not to exceed sixty months.

Signed: Karen Gochnauer date 8-27-07 Installed by: Tim Abee Grading

Improvement Permit by: STEVE HEDRICK date 8-27-07 Operation Permit by: STEVE HEDRICK date 7-28-07

Authorization to Construct by: STEVE HEDRICK date 8-27-07 Existing System Inspection by: _____ date _____

HEALTH DEPT. COPY: WHITE OWNER COPY (FINAL): YELLOW OWNER COPY (INITIAL): PINK