IREDELL COUNTY HEALTH DEPARTMENT

STATESVILLE 704-878-5305 MOORESVILLE 704-664-5281

IMPROVEMENT PERMIT / AUTHORIZATION TO CONSTRUCT / OPERATION PERMIT / EXISTING SYSTEM INSPECTION

PERMIT# 140883 PIN# 9872175364 69959 DATE 6-11-07

OWNER OR APPLICANT Karen Cochnauer PHONE: Business Home 704-892-1998

ADDRESS 16715 DAVIDSON CONCORD RD DAVIDSON NC 28036

LOCATION 77N Exit 65 (R) 901 (L) Eagle Mill (R) Davidson Rd (L) Troy Mill (L) York SPAD

SUBDIVISION BLOCK / SECTION LOT LOT AREA 13.71 SITE CLASS 25 DESIGN FLOW 360 L.T.A.R. .25

Septic Tank: 1000 Gallons; STB 166 Date 5-19-08

Pump Tank: Gallons; PT Date

Pump Make: Model Serial No.

Nitrification Field: No Fields Square Feet 1440 Linear Feet 360

No Lines 4 Trench Width 36, 11 Max Trench Bottom Depth 36 Gravel Depth ☐ Gravity ☐ Pressure

☑ New System ☐ Repair ☐ Expansion System Type: I II III IV V VI

System Description: 25% Conv

Repair System Description: 25% Conv

Maintenance Agreement Required: ☐ Yes ☐ No

☑ House/Mod. Home No. Bedrooms 3

☐ Mobile Home No. Persons

☐ Business No. Employees

☐ Other

Water Supply: ☑ Individual ☐ Public ☐ Community

☐ Slab ☑ Crawl Space ☐ Basement w/plumbing ☐ Basement wo/plumbing


Comments:/Conditions:

* NOT to SCALE


Comments:/Conditions:

* Call Health Department before installation for Flagging

INITIAL SITE SKETCH

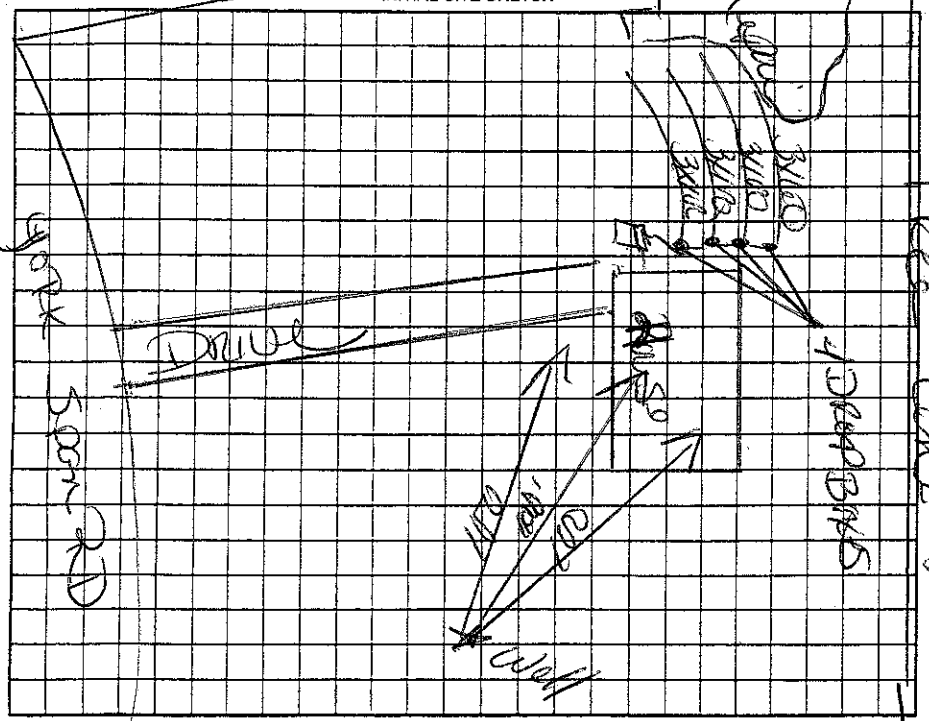

AS BUILT SKETCH

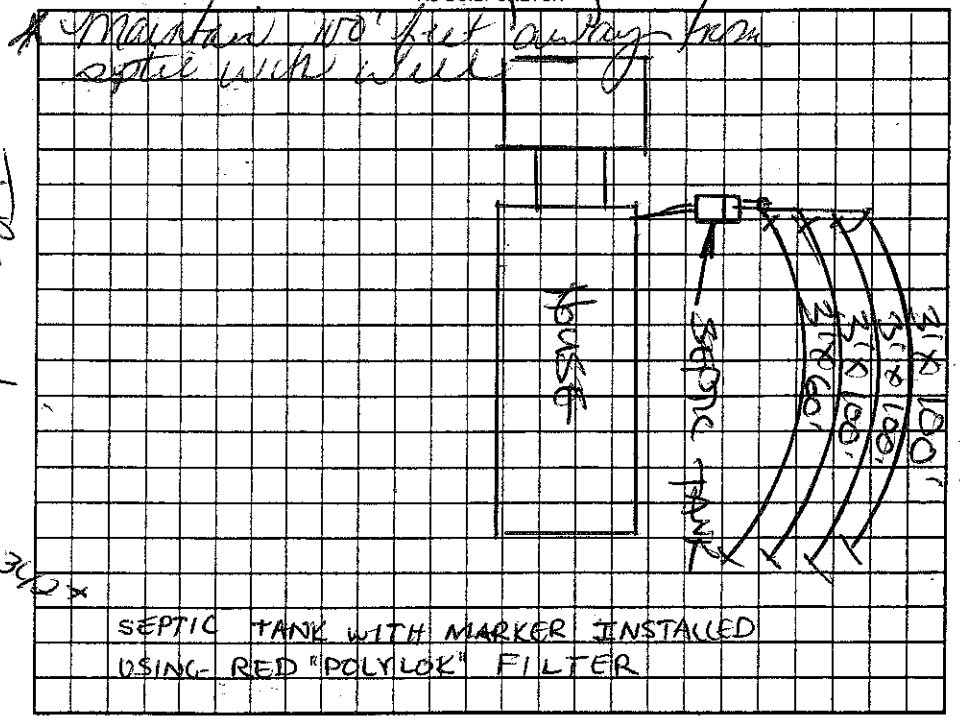

Permit can be ~~suspended~~ or revoked if any false information is supplied toward securing the permit/any unauthorized changes are made to the site/any unauthorized changes are made in the installation of the system. Improvement Permit with plat valid without expiration ☐ Improvement Permit with site plan valid for sixty months ☐ Authorization to Construct is valid for a period equal to that of Improvement Permit – not to exceed sixty months.

Signed: Karen Cochnauer date 6-15-07

Improvement Permit by: date 6-11-07

Authorization to Construct by: date 6-11-07

Installed by: TM ABEE GRADING

Operation Permit by: STEVE HEDRICK date 7-28-08

Existing System Inspection by: date

HEALTH DEPT. COPY: WHITE OWNER COPY (FINAL): YELLOW OWNER COPY (INITIAL): PINK