IREDELL COUNTY HEALTH DEPARTMENT

STATESVILLE 704-878-5305 MOORESVILLE 704-664-5281

IMPROVEMENT PERMIT / AUTHORIZATION TO CONSTRUCT / OPERATION PERMIT / EXISTING SYSTEM INSPECTION

PERMIT# 088886 PIN# 4872 17 1255 DATE 5-10-00

OWNER OR CONTRACTOR MANDIE NORMAN SPANN PHONE: Business Home 539-4659

ADDRESS P.O. BOX 264, HARMONY NC 28634

LOCATION US 21 N, TL NC 901, TR EAGLE MILLS ROAD, TR YORK SPANN ROAD, 1.3 MILES ON LEFT

SUBDIVISION BLOCK / SECTION LOT LOT AREA 1.518 ACRES SITE CLASS PS DESIGN FLOW 360 L.T.A.R. 0.40 GPD/FT2

Septic Tank: 1000 Gallons; STB 620 Date 3-15-00

Pump Tank: Gallons; PT Date

Pump Make: Model Serial No.

Nitrification Field: No Fields 1 Square Feet 900 Linear Feet 300

No Lines THREE Trench Width 36" Max Trench Bottom Depth 36" Gravel Depth 12"

☑ New System ☐ Repair System Type: I (II) III IV V VI

System Description: CONVENTIONAL, SPANN

Repair System Description: CONV. SPANN

Maintenance Agreement Required: ☐ Yes ☑ No

☐ House/Mod. Home No. Bedrooms 3

☑ Mobile Home No. Bathrooms 2

☐ Business No. Employees

☐ Other

☐ Slab ☑ Crawl Space ☐ Basement w/plumbing ☐ Basement wo/plumbing


Water Supply: ☑ Individual ☐ Public ☐ Community

WELL


Comments/Conditions:

Comments/Conditions: SEPTIC TANK W/ RISERS INSTALLED USING "THETITE" FILTER

INITIAL SITE SKETCH

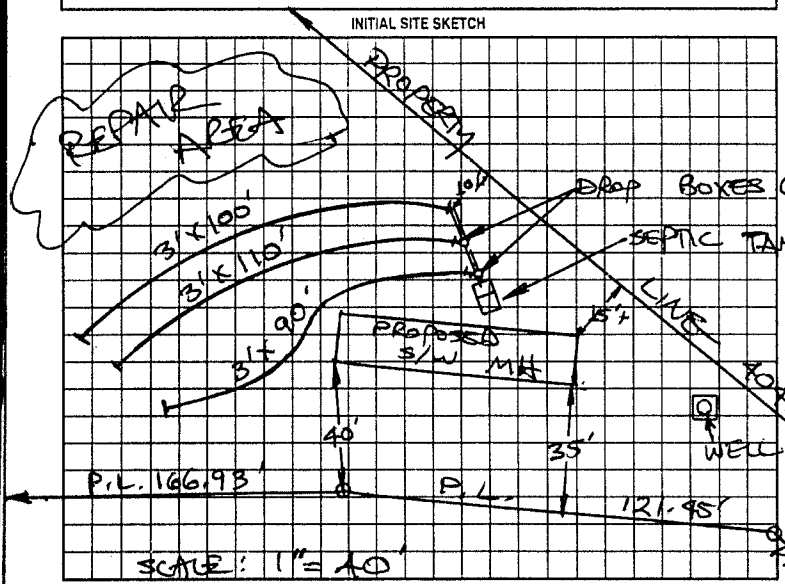

AS BUILT SKETCH

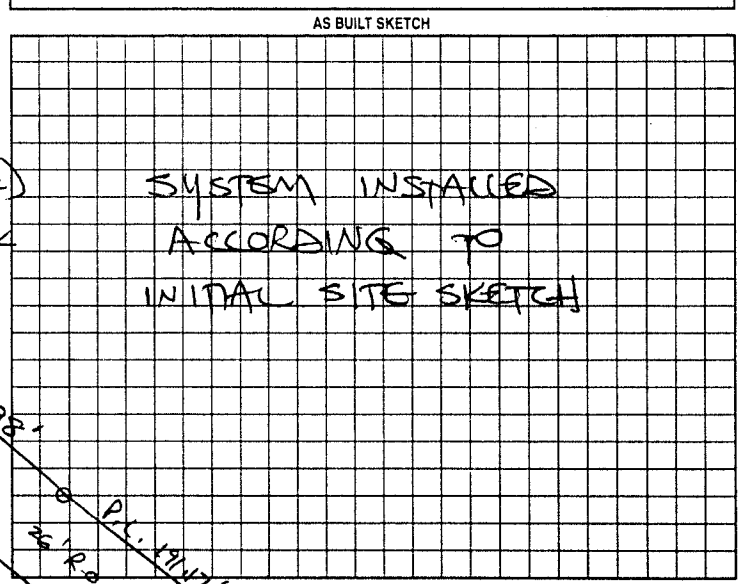

Permit can be suspended or revoked if any false information is supplied toward securing the permit/any unauthorized changes are made to the site/any unauthorized changes are made in the installation of the system. Improvement Permit with plat valid without expiration. Improvement Permit with site plan valid for sixty months. Authorization to Construct is valid for a period equal to that of Improvement Permit – not to exceed sixty months.

Signed: Mandie N. Spann date 5-10-00 Installed by: SAMMY REAVIS

Improvement Permit by: STEVE HENDRICK date 5-10-00 Operation Permit by: STEVE HENDRICK date 10-8-2000

Authorization to Construct by: STEVE HENDRICK date 5-10-00 Existing System Inspection by: date

HEALTH DEPT. COPY: WHITE OWNER COPY (FINAL): YELLOW OWNER COPY (INITIAL): PINK